


T.20S., R. 28E., W.M.

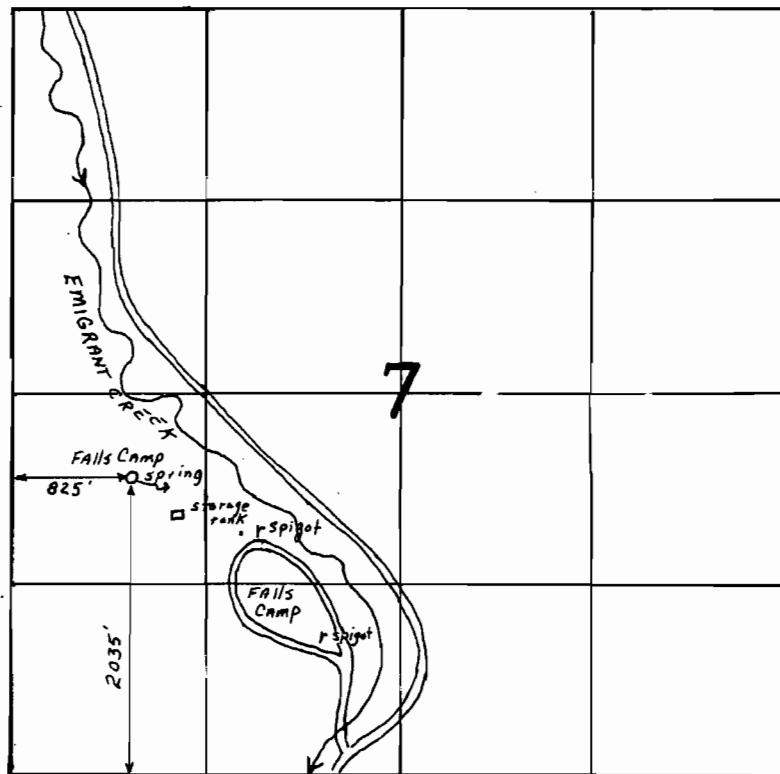

SCALE - 4" = 1 MILE

RECEIVED

JUN 8 1983

**WATER RESOURCES DEPT.
SALEM, OREGON**

RECEIVED

MAY 8 1983

**WATER RESOURCES DEPT.
SALEM, OREGON**

Application No. 00865

Permit No. 48518