


A-68983

(AMENDED)  
N  
1" = 1000'

T13S R34 & 35E WM

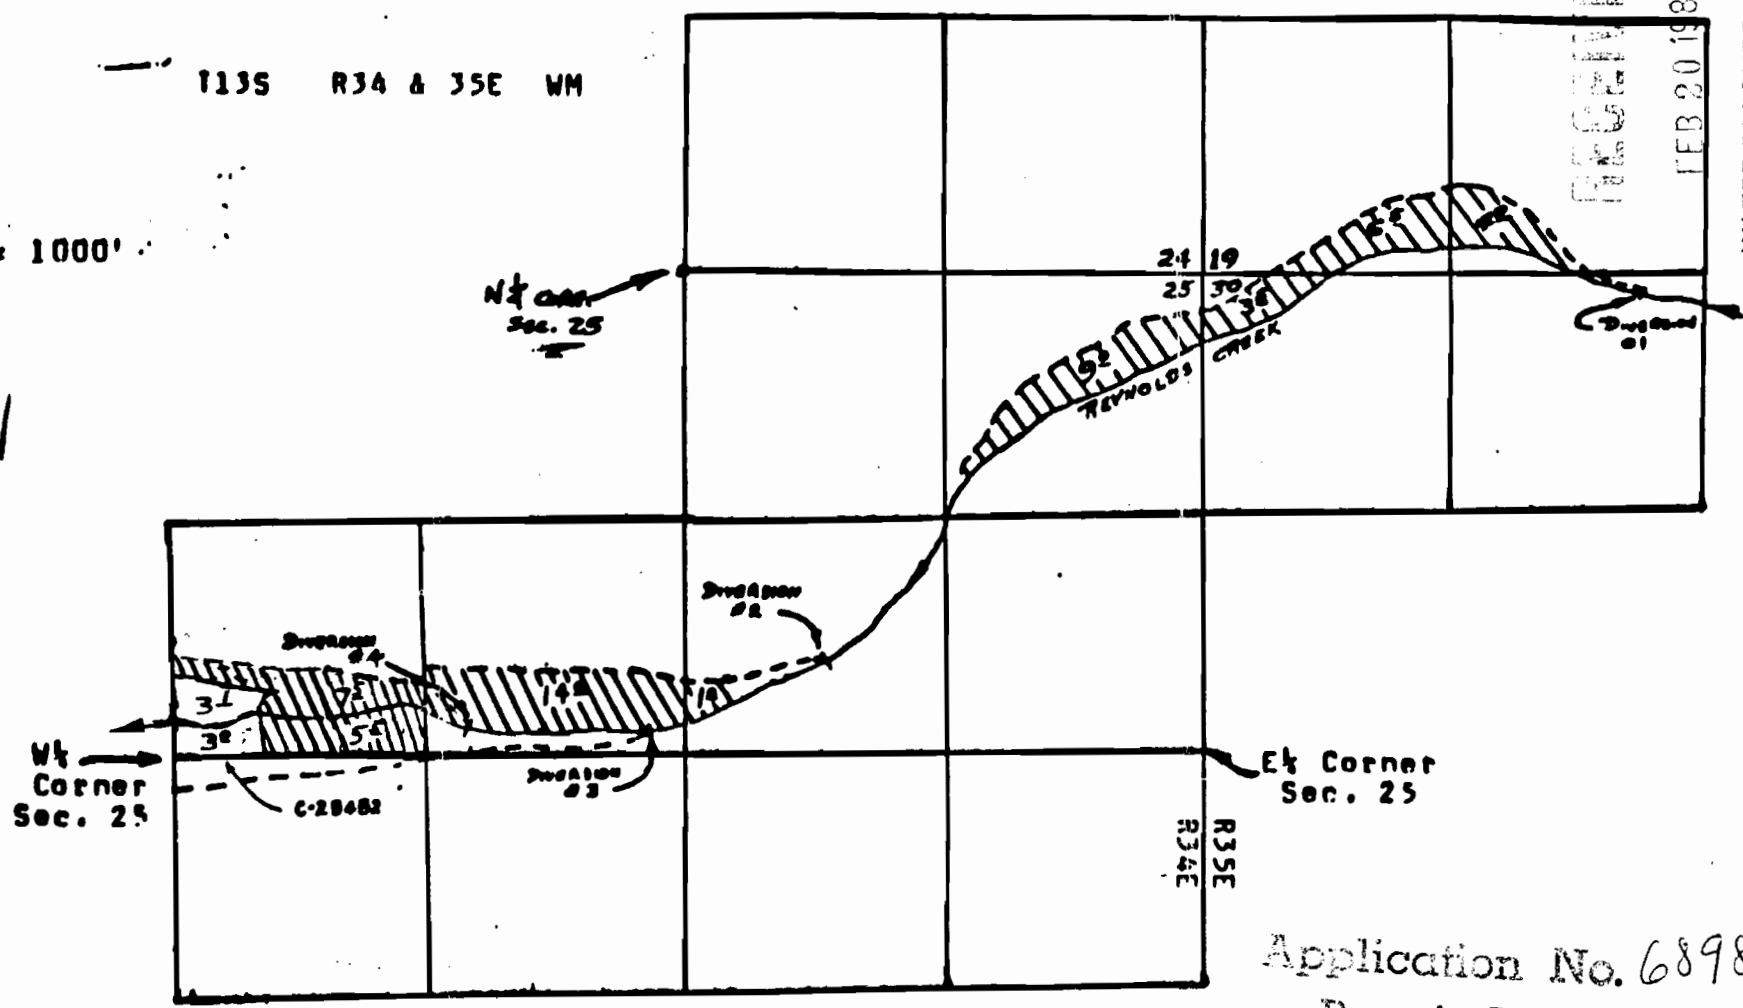

RECEIVED  
FEB 20 1987

WATER RESOURCES DEPT.  
SALEM, OREGON

Application No. 68983  
Permit No. 49972

DIVERSION LOCATIONS

- DIVERSION #1: 100 ft. South and 300 ft. West from the North 1/4 corner of Sec. 30, T.13S.,R.35E., WM.
- DIVERSION #2: 2100 ft. South and 700 ft. East from the North 1/4 corner of Sec. 25, T.13S.,R.34E., WM.
- DIVERSION #3: 2450 ft. South and 200 ft. West from the North 1/4 corner of Sec. 25, T.13S.,R.34E., WM
- DIVERSION #4: 2450 ft. South and 1100 ft West from the North 1/4 corner of Sec. 25, T.13S.,R.34E., WM