

SECTION PLAT

Section 25 Township 25 Range 33
 County of HARNEY State of ORE


NORTH

RECEIVED
 MAY 11 1977
 WATER RESOURCES DEPT
 SALEM, OREGON

Application No. G-8118
 Permit No. G 7549

25

THIS MAP PREPARED BY:
William H. Beas
 FROM INFORMATION FURNISHED BY
 THE APPLICANT.

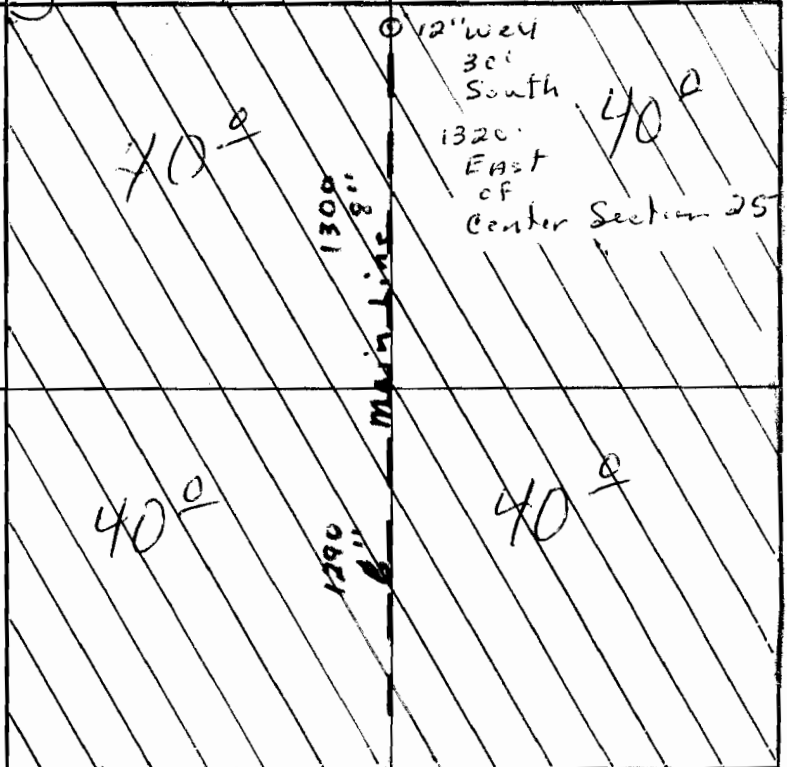

S

Remarks scale - 8" = 1 mile - 660' -