


T. 9 S., R. 26 E., W.M.

APPLICATION MAP FOR

TOM ORTON

Application No. 65247

Permit No. 47669

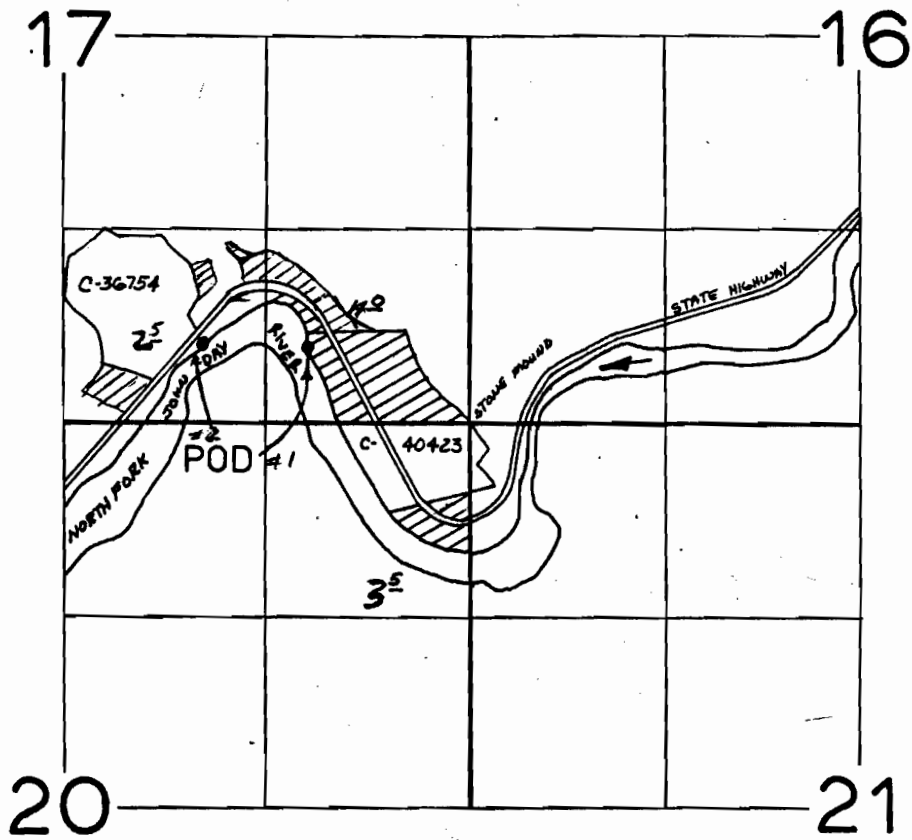

*1 POD is to be located 540 ft N & 1120 ft W from the SE corner of Section 17, T9N, R26E, WM

*2 POD is 540' N & 1820' W from SE corner of SEC. 17

APPROVED

RECEIVED
JUN 30 1983
WATER RESOURCES DEPT.
SALEM, OREGON