


T 16 S, R 26 E

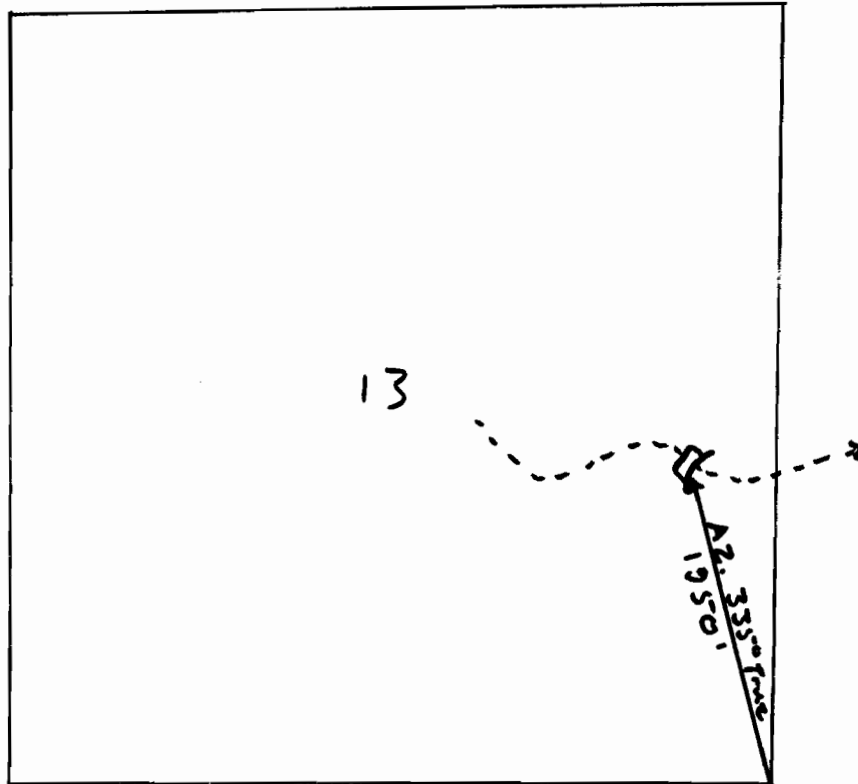

Wildhorse Res.

Application No. R-66333
Permit No. R11392

SEP 9 1983
SALMON DIVISION
SALMON DIVISION