


T 17 S , R 26 E

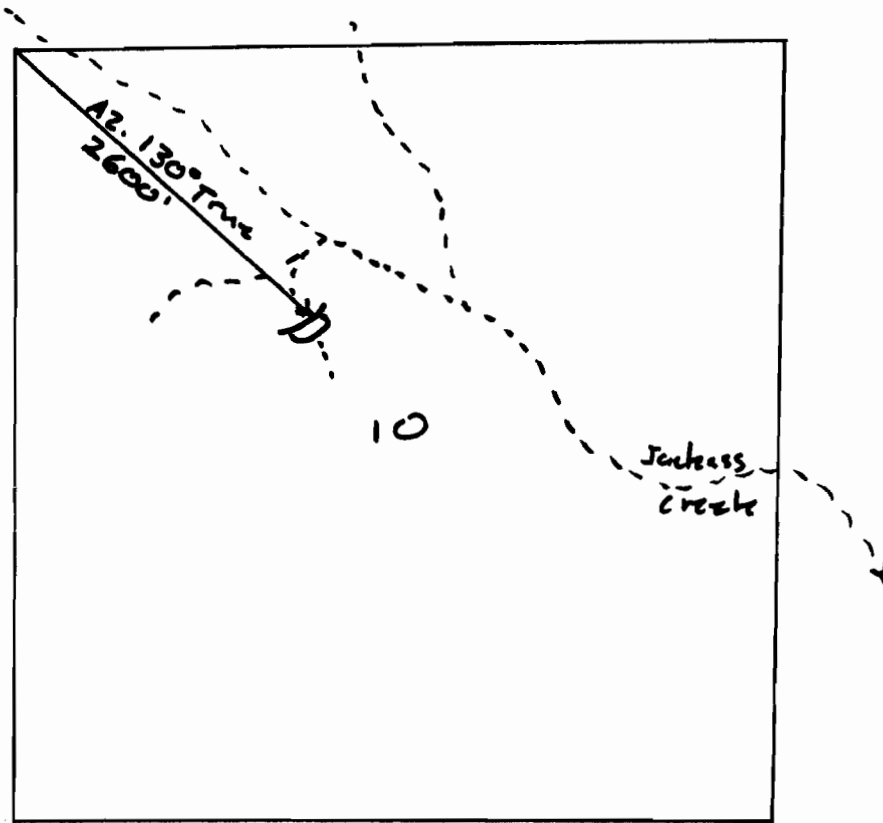

Thursday Res.

Applicant No. R-66334
Permit No. R11393

S. 9 1983
S. DEPT.
SALEM, OREGON

T 17 S , R 26 E , WM