


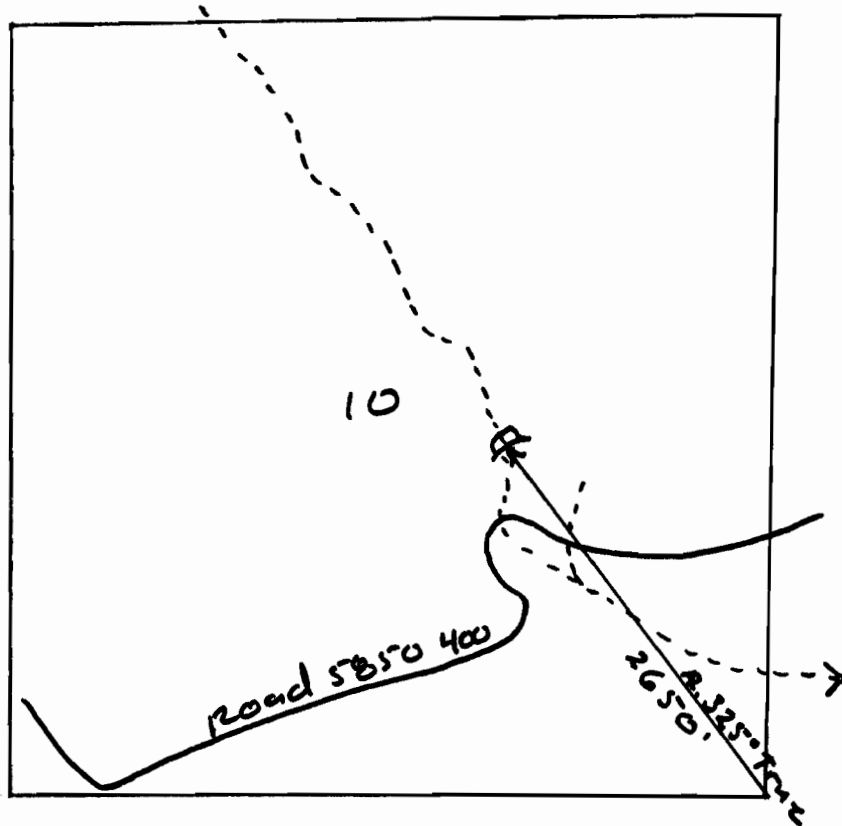

Elbow Gulch Res.

SEP 29 1983
 LAND & NATURAL RES DEPT.
 SALEM, OREGON

Applicant No. R-66335
 Permit No. R11394

T 15 S , R 26 E , WM