


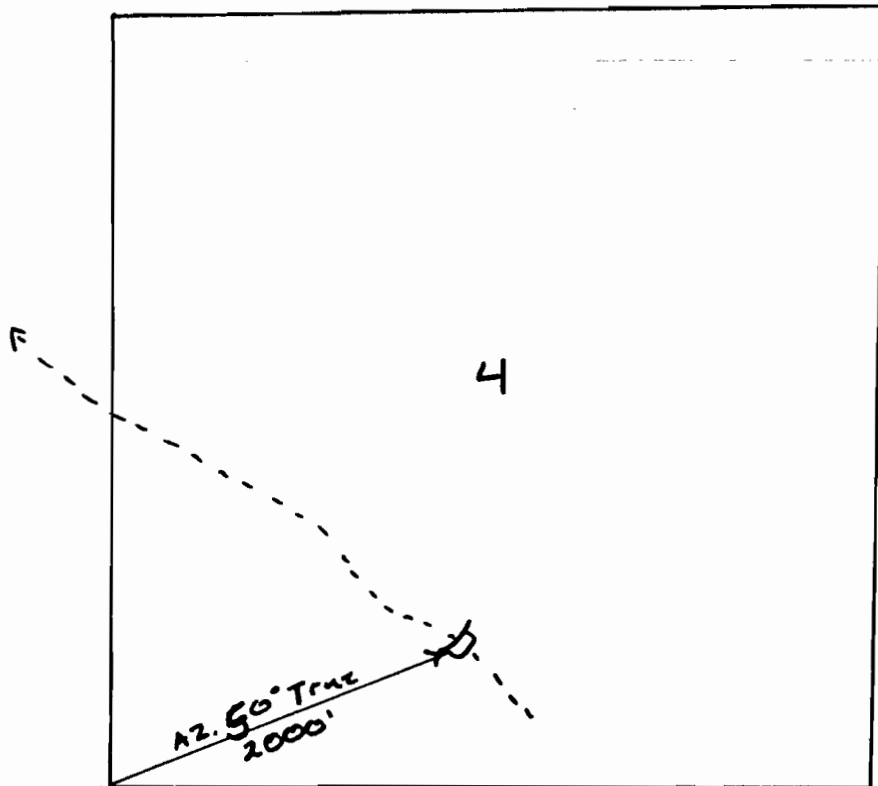

Elk. Res.

FILED
 SEP 19 1983
 SALEM, OREGON

Application No. R-66336
 Permit No. R11395

T 16 S R 26 E, WM