


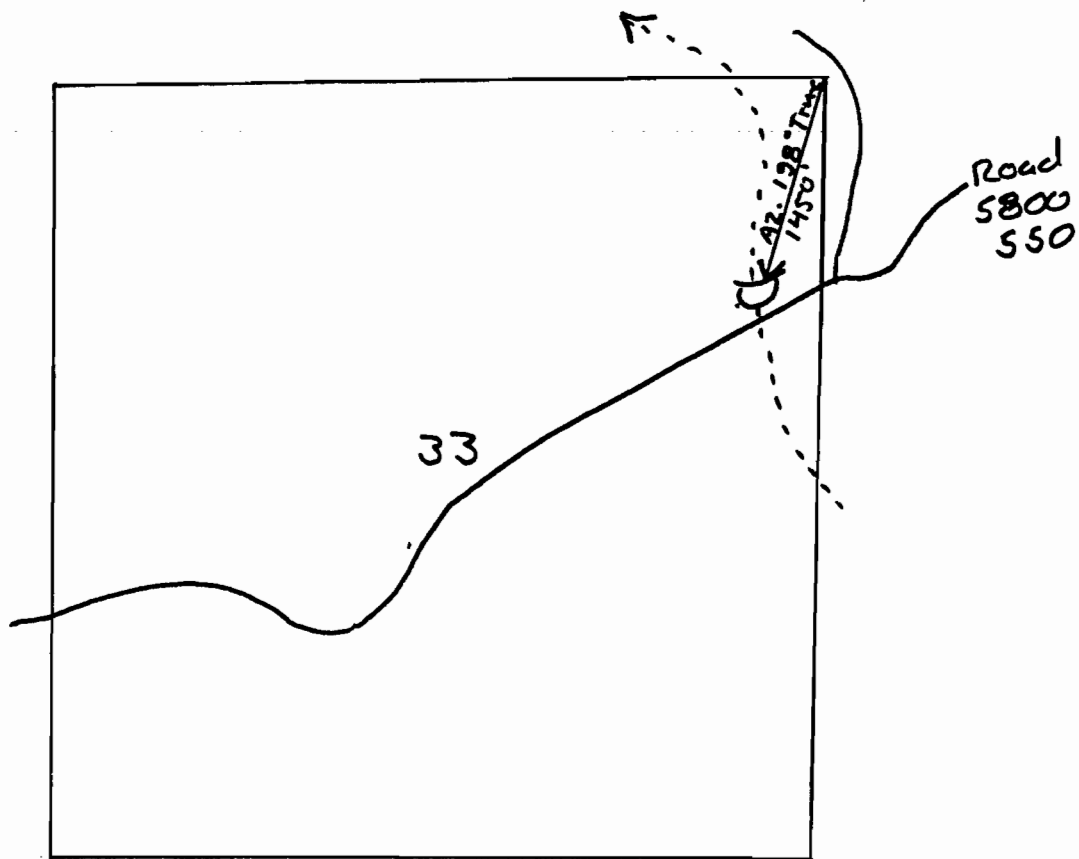

Mule Res.

Application No. R-66337
Permit No. R11396

SEP 19 1983
LAND MANAGEMENT DEPT.
SALEM, OREGON

T 15S, R 26 E, W.M.