


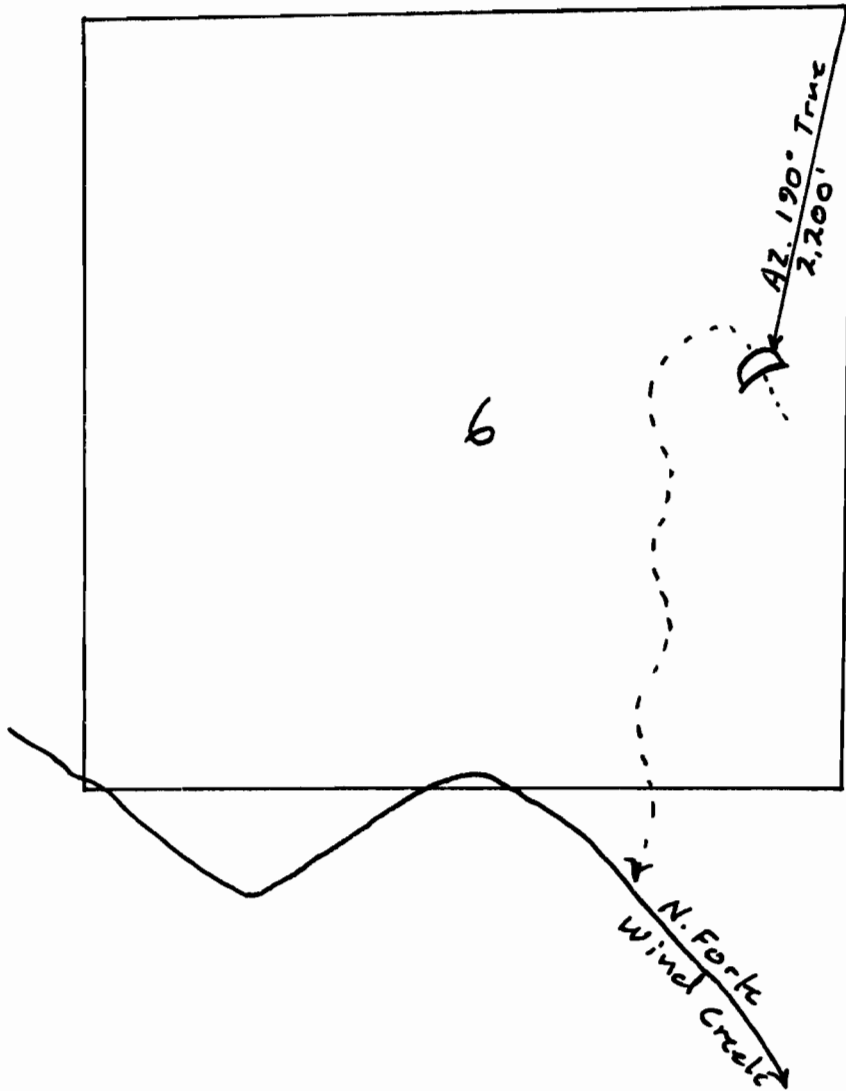

10
 SEP 9 1983
 LAND & MINES DEPT.
 SALEM, OREGON

Dry Gulch Res.

Application No. R-66338
 Permit No. R11397

T 15 S, R 26 E