


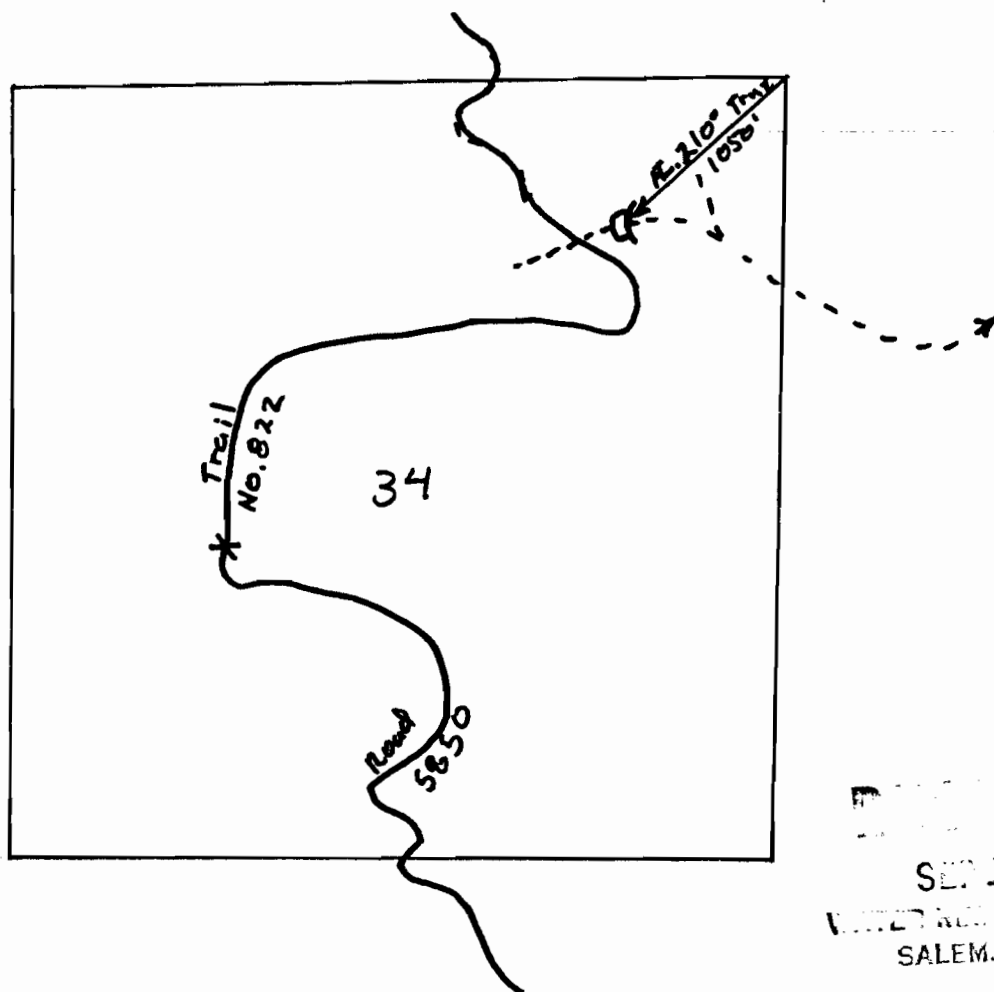

RECEIVED
SEP 19 1983
WATER RESOURCES DEPT.
SALEM, OREGON

North Corner Res.

Application No. R-66339
Permit No. R11398

T 14 S, R 26 E