


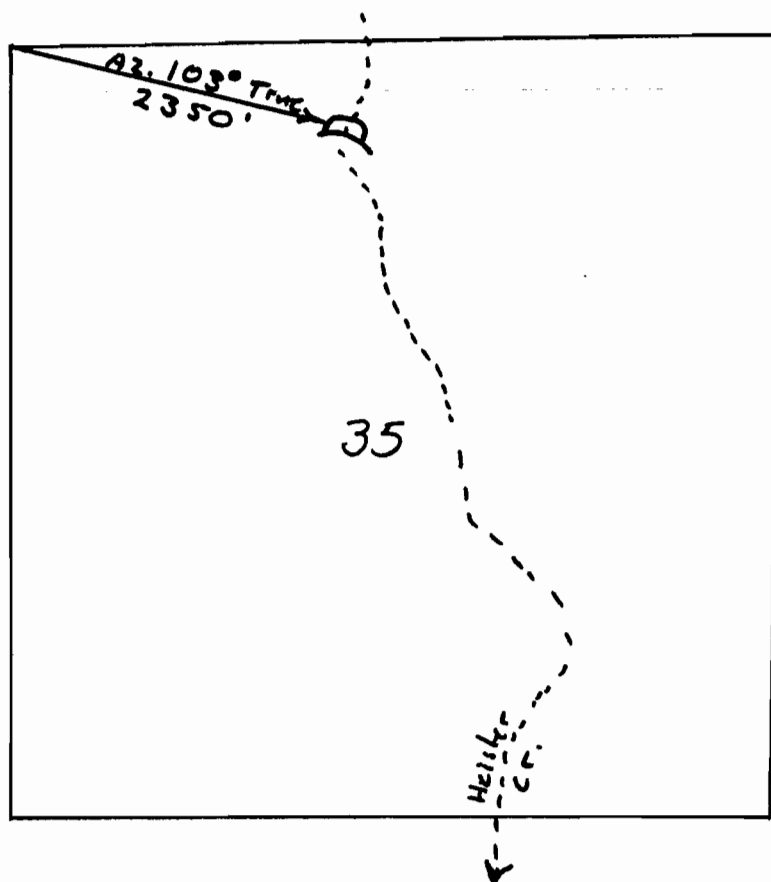

Heister Res.

T15S, R25E

Application No. R-66340

Permit No. R11381

SEP 9 1983  
 WILSON'S DEPT.  
 SALEM, OREGON