


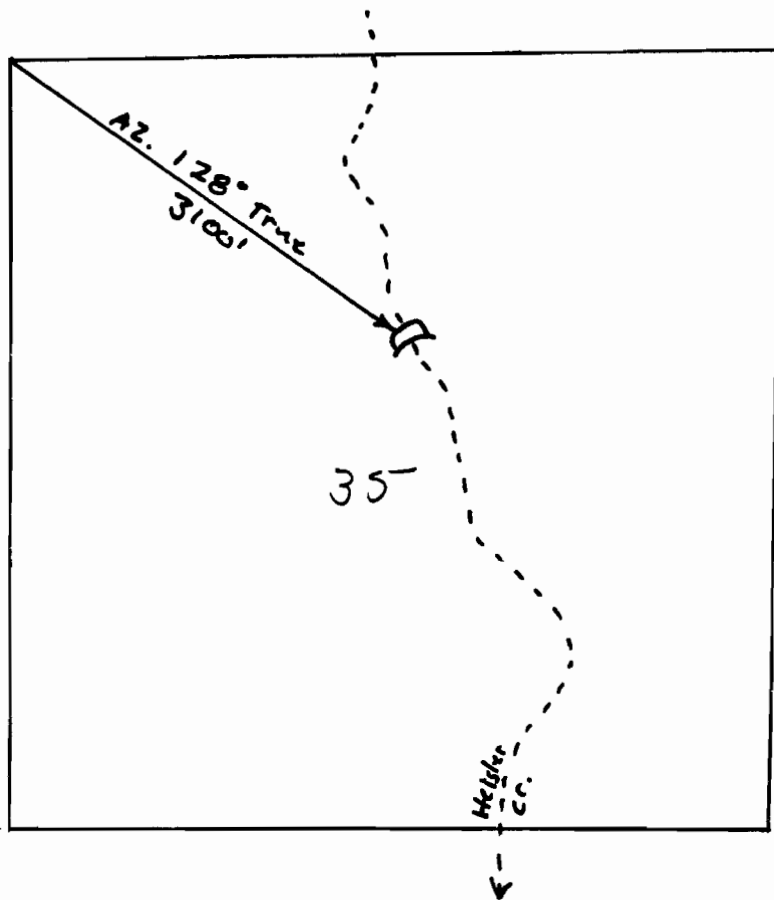

Heister Two Res.

S. 9 1983
 L. RES. DEPT.
 SALEM, OREGON

Application No. R-66341
 Permit No. R11382