


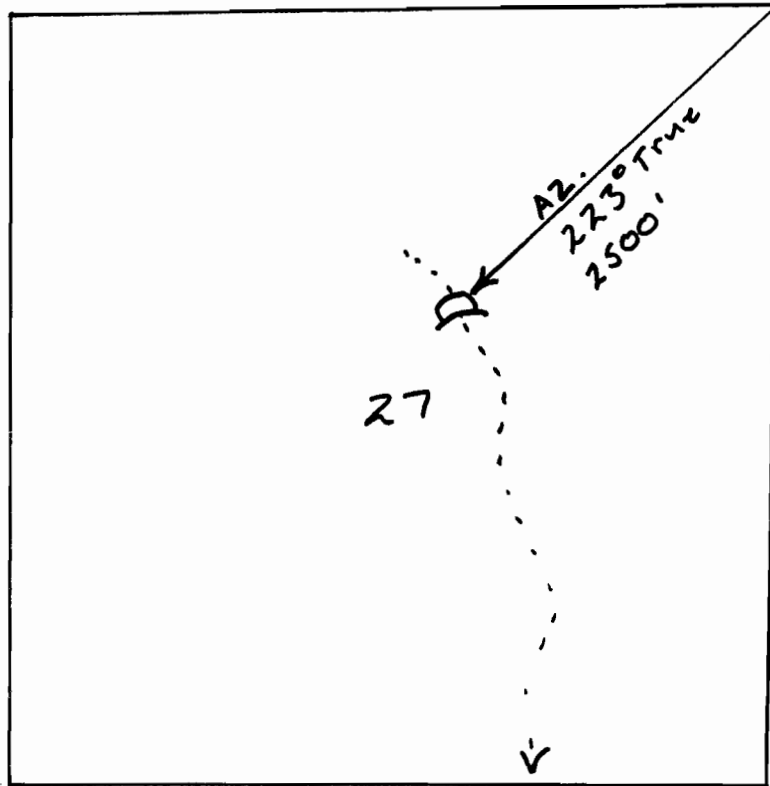

Bear Butte Res.

SEP 29 1983
 U.S. DEPT. OF THE INTERIOR
 BUREAU OF LAND MANAGEMENT
 SALT LAKE CITY, UTAH

Application No. R-66342
 Permit No. R11383

T 15S, R 25E