


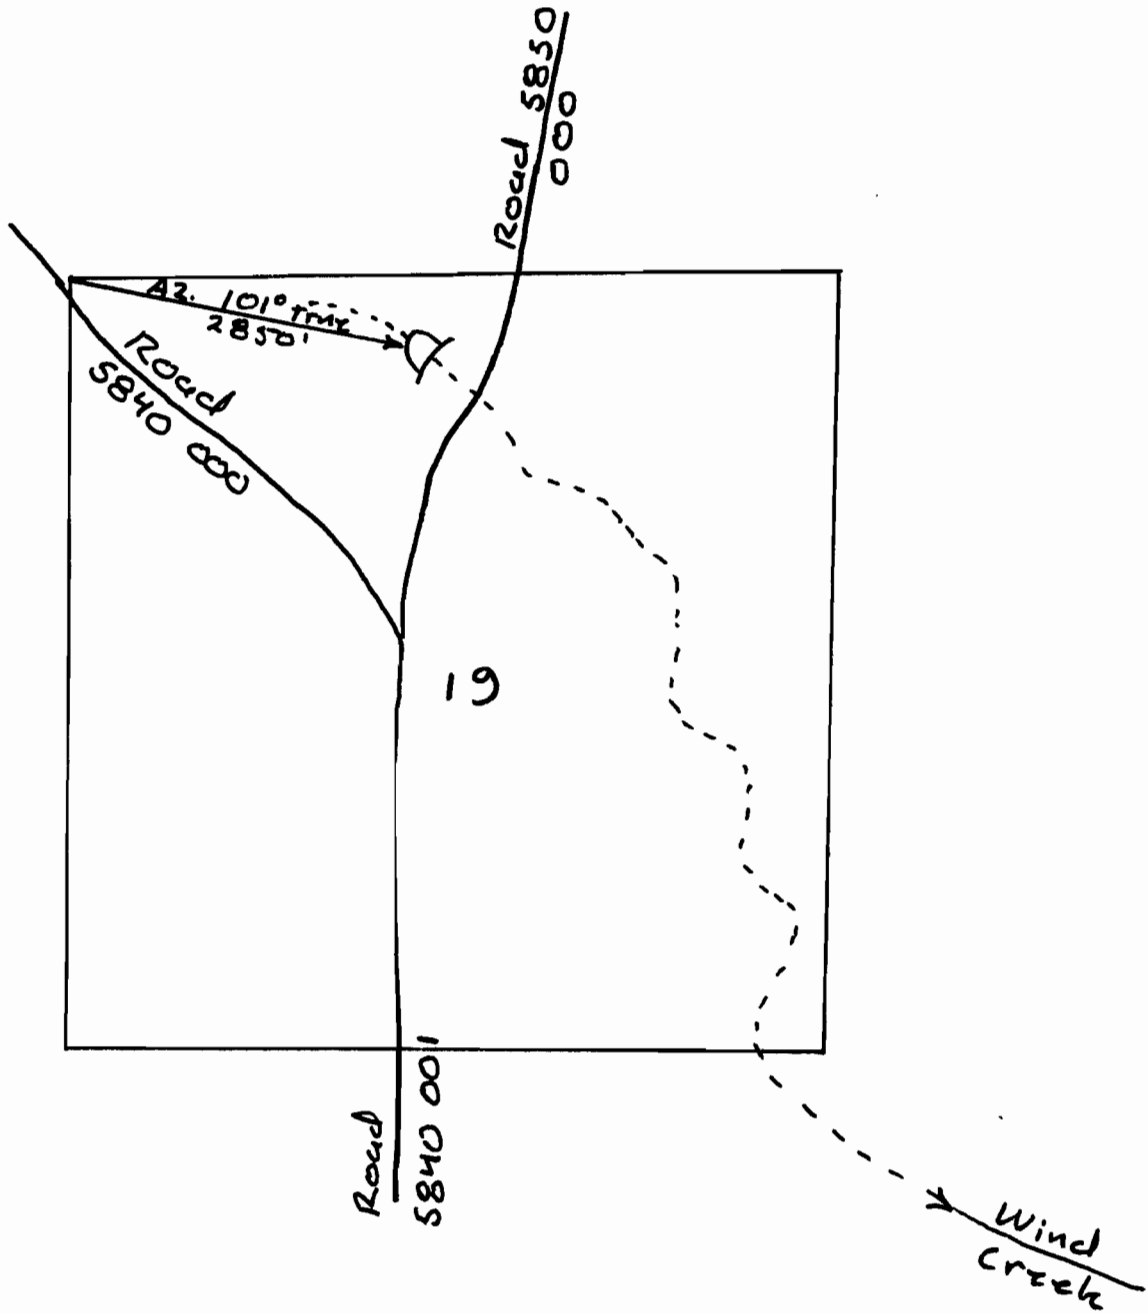

Clay Pit Res.

Application No. R-66343
 Permit No. R11399

T15S, R26E

SEP 29 1983
 SALEM, OREGON