


T.18&2S.,R.10E,W.M.

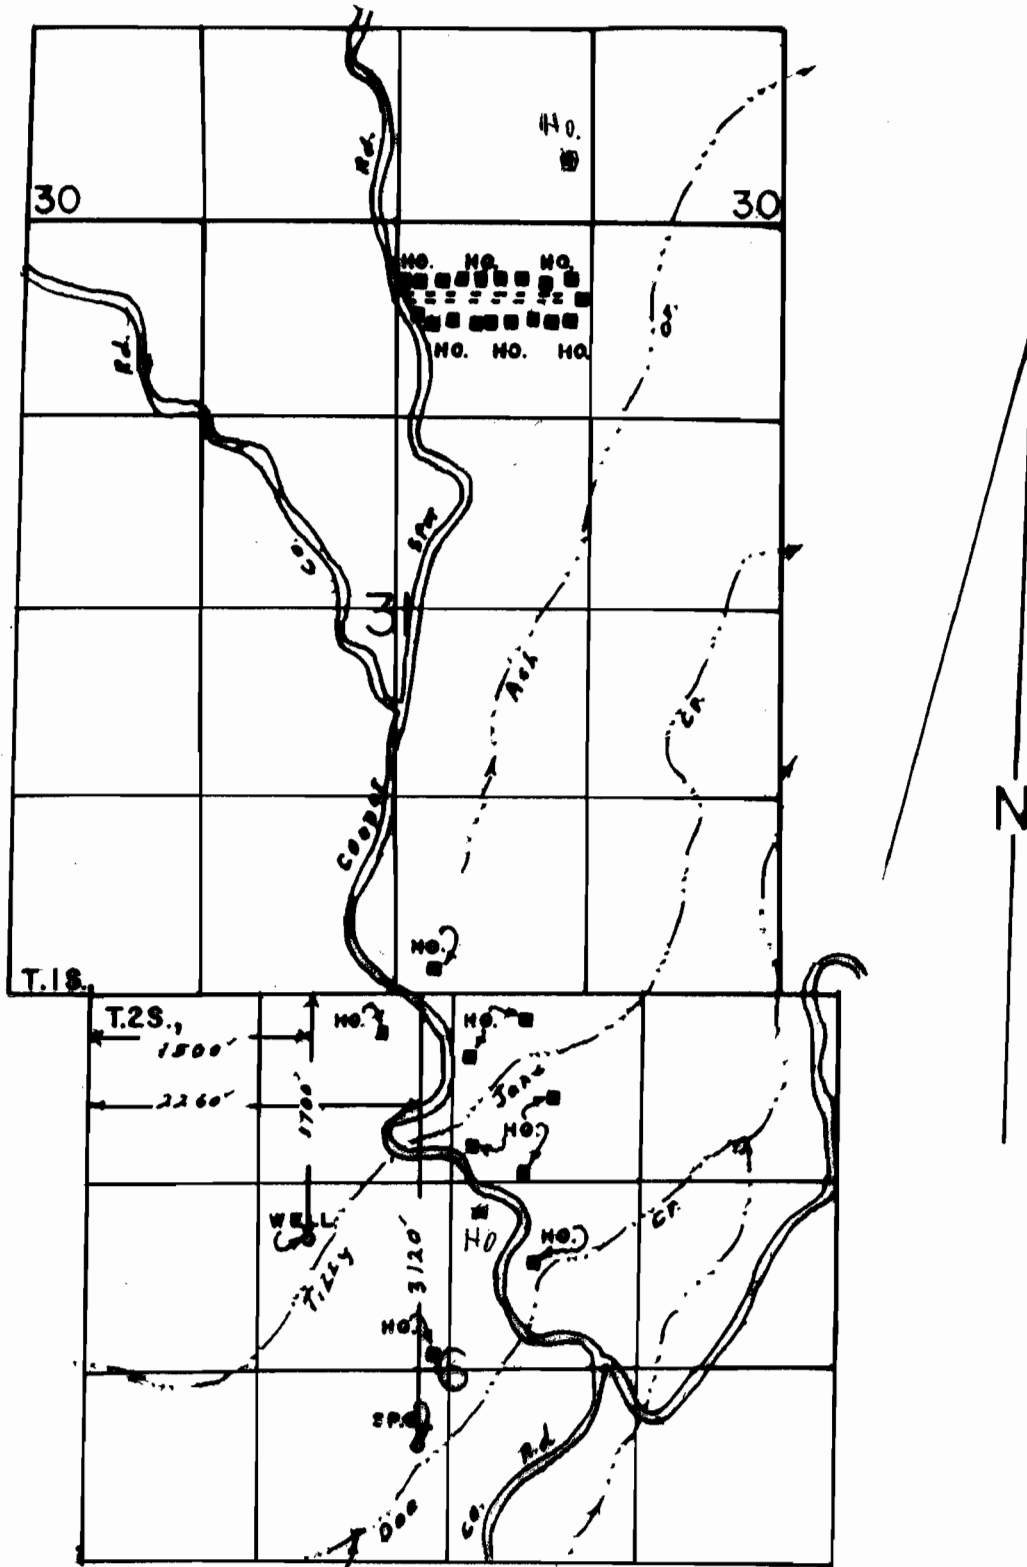

SCALE: 1" = 1320'

FINAL PROOF SURVEY

UNDER
APPLICATION NO. G-8524 PERMIT NO. 36149 G-7601
DONALD J. BRANTON

SURVEYED SEPT. 1, 1985, BY R.M. SUTTERFIELD 5/5/06 JWG
3-8-96 R.M.S.