


T.1&2S.,R.10E,W.M.

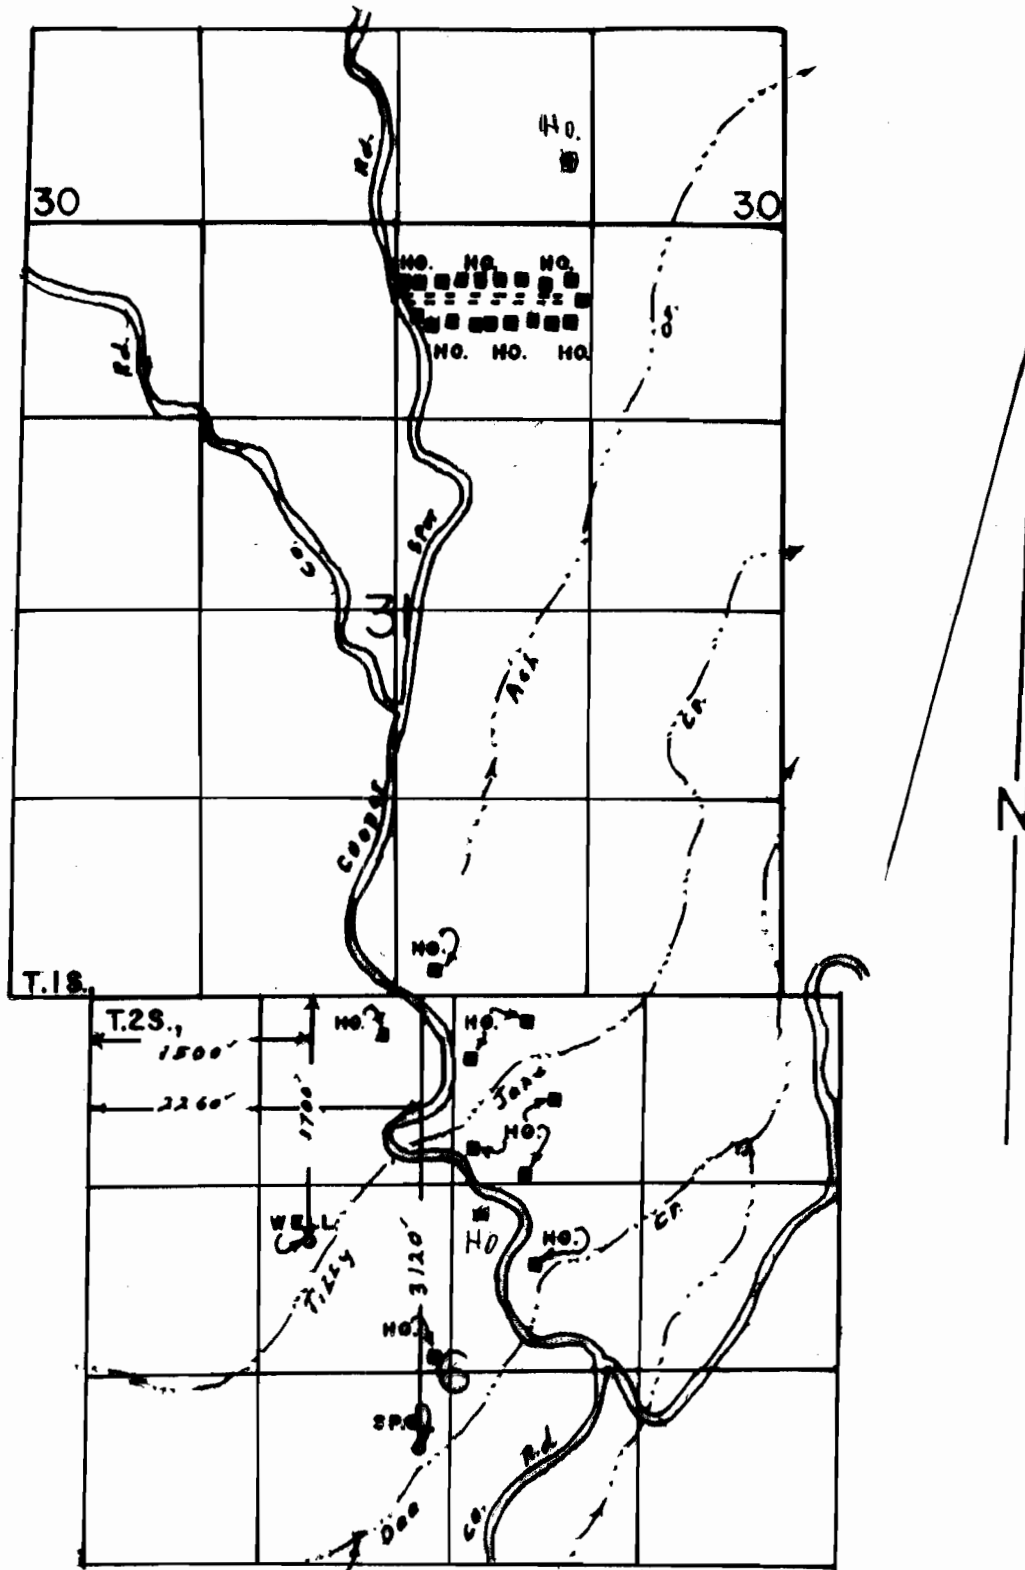

SCALE: 1" = 1320'

FINAL PROOF SURVEY

UNDER
APPLICATION NO. 9-8324 PERMIT NO. 36149
DONALD J. BRANTON
SURVEYED SEPT. 1, 1995 BY R.M. SUTTERFIELD

5/5/06 JWG
2-6-96 R.M.S.