


T. 26 S., R 29 E., W. M.

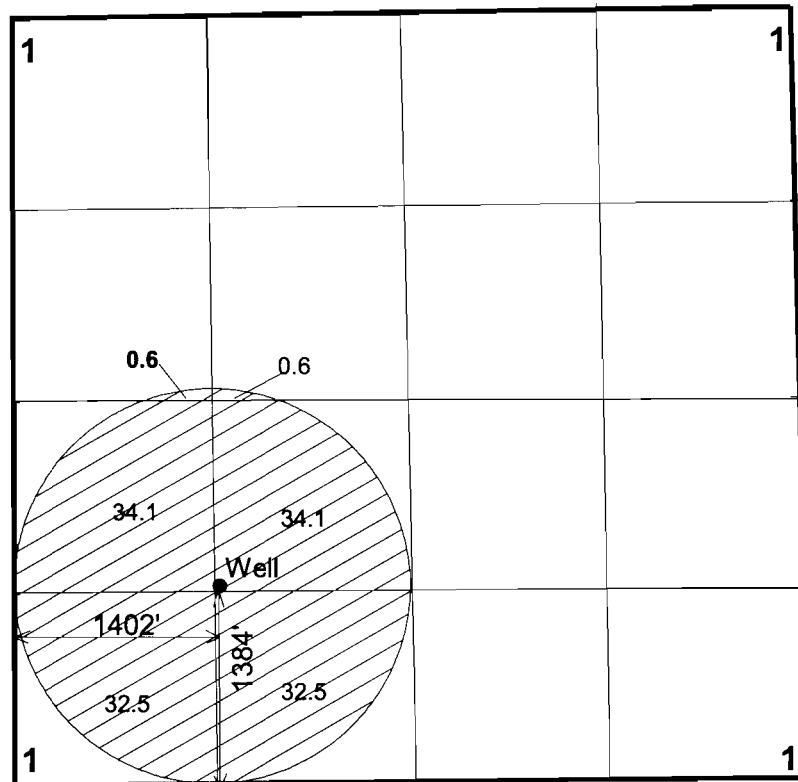

1' = 1320'

FINAL PROOF SURVEY
UNDER

Application No. G-11107 Permit No. G-10356

IN THE NAME OF
JOE F. MOON

Surveyed August 08, 2001, by J. Miller