
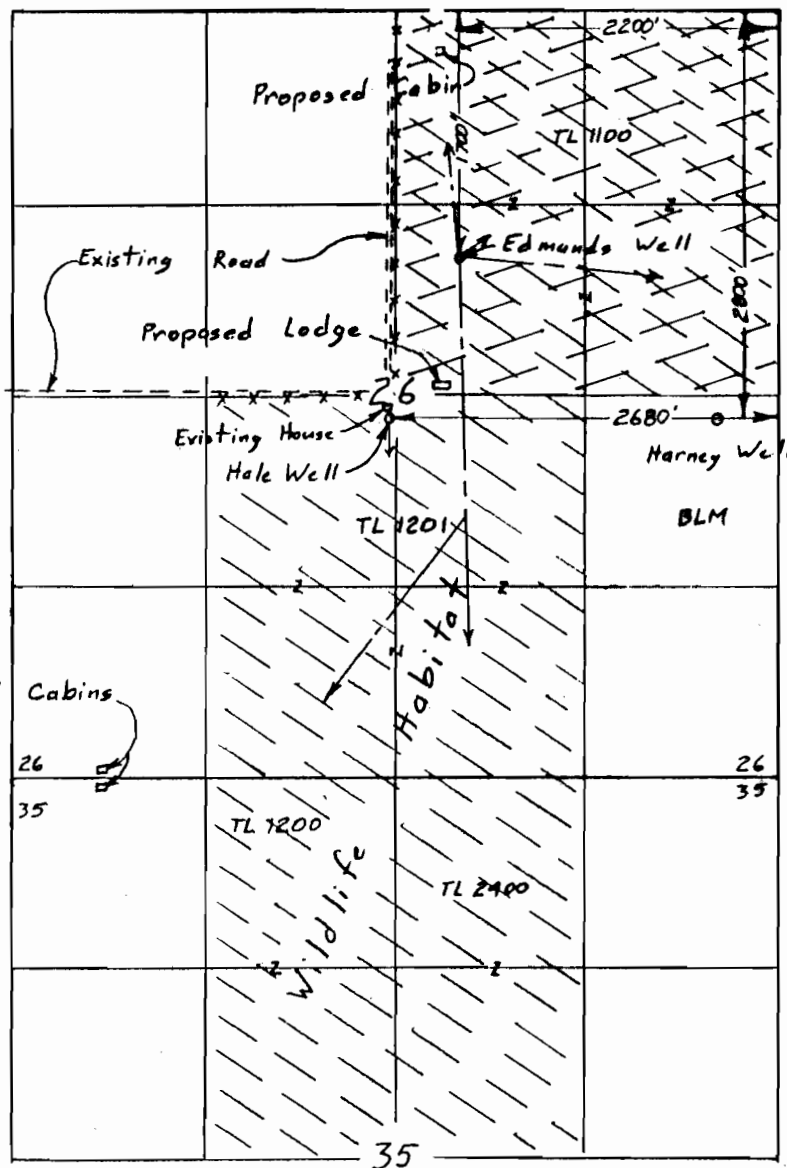


LAKE COUNTY

TOWNSHIP 29 SOUTH, RANGE 17 EAST, W.M.

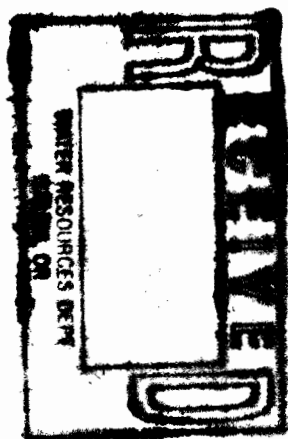

⊖ G-10729
⊖ G-11952

Scale 1"=1320'
(4"=1 mile)

Surveyed Sep 15, 2000

Claim of Beneficial Use Map
for
DON & CAROL EDMUNDS

App G-11659 & G-13639
Per G-10729 & G-11952



This map is for the purpose of
locating a water right only
and has no intent to provide
legal dimensions or the location
of property lines.

ESTES SURVEYS, LLC

PO Box 17519 60382 Arnold Rd
Salem, OR 97305-7519 Bend, OR 97702
(503) 585-7593 (541) 382-7391