

1" = 400'

SEE MAP 5S 10

FINAL PROOF SURVEY

UNDER


Application No. 59913 Permit No. 45502
R 59912 R 8229

IN NAME OF

PATRICIA A. GRIFFITH & KATRINE F. B. DAY

Surveyed APRIL 30 1991, by R. W. KLASSEN

TSS
R9W

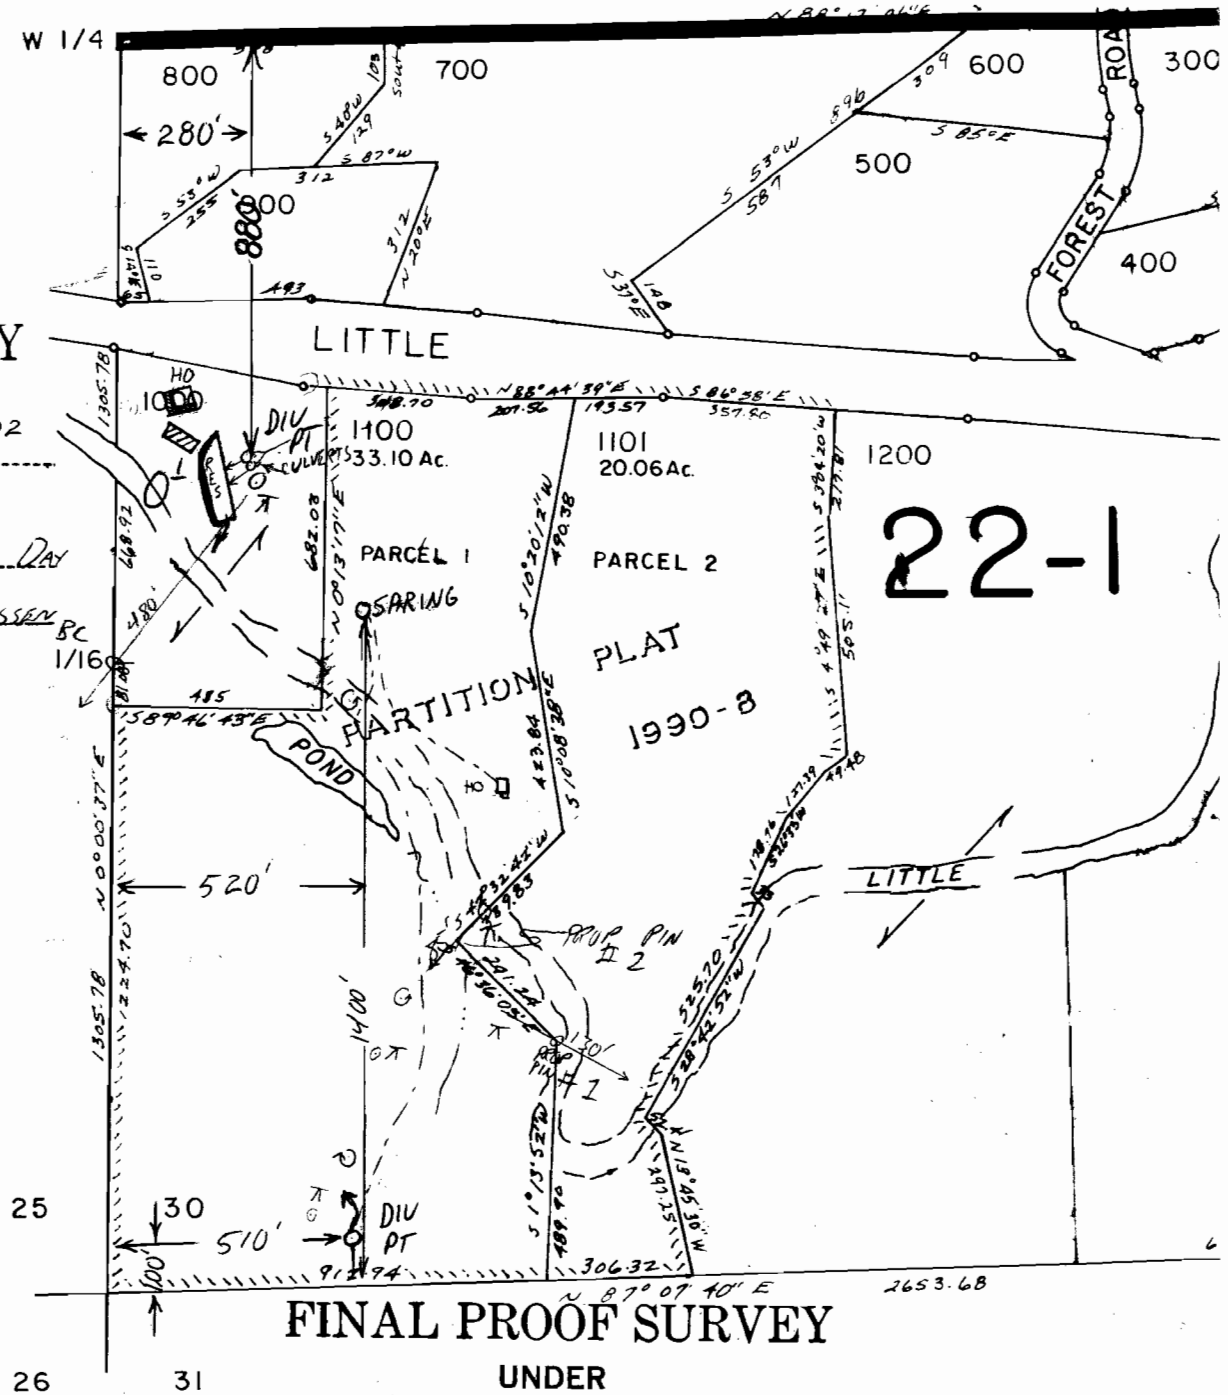

Application No. 69181 Permit No. 50084

IN NAME OF

ROBERT L. BAIRD

Surveyed APRIL 30 1991, by P. L. V.