

1" = 400'

SEE MAP 5S 10

FINAL PROOF SURVEY


UNDER

Application No. 59913 Permit No. 46502
59912 Permit No. R.B.229

IN NAME OF

PATRICIA A. GRIFFITH & KATRINE E. B. DAY

Surveyed April 30 1991, by R. L. KLASSEN

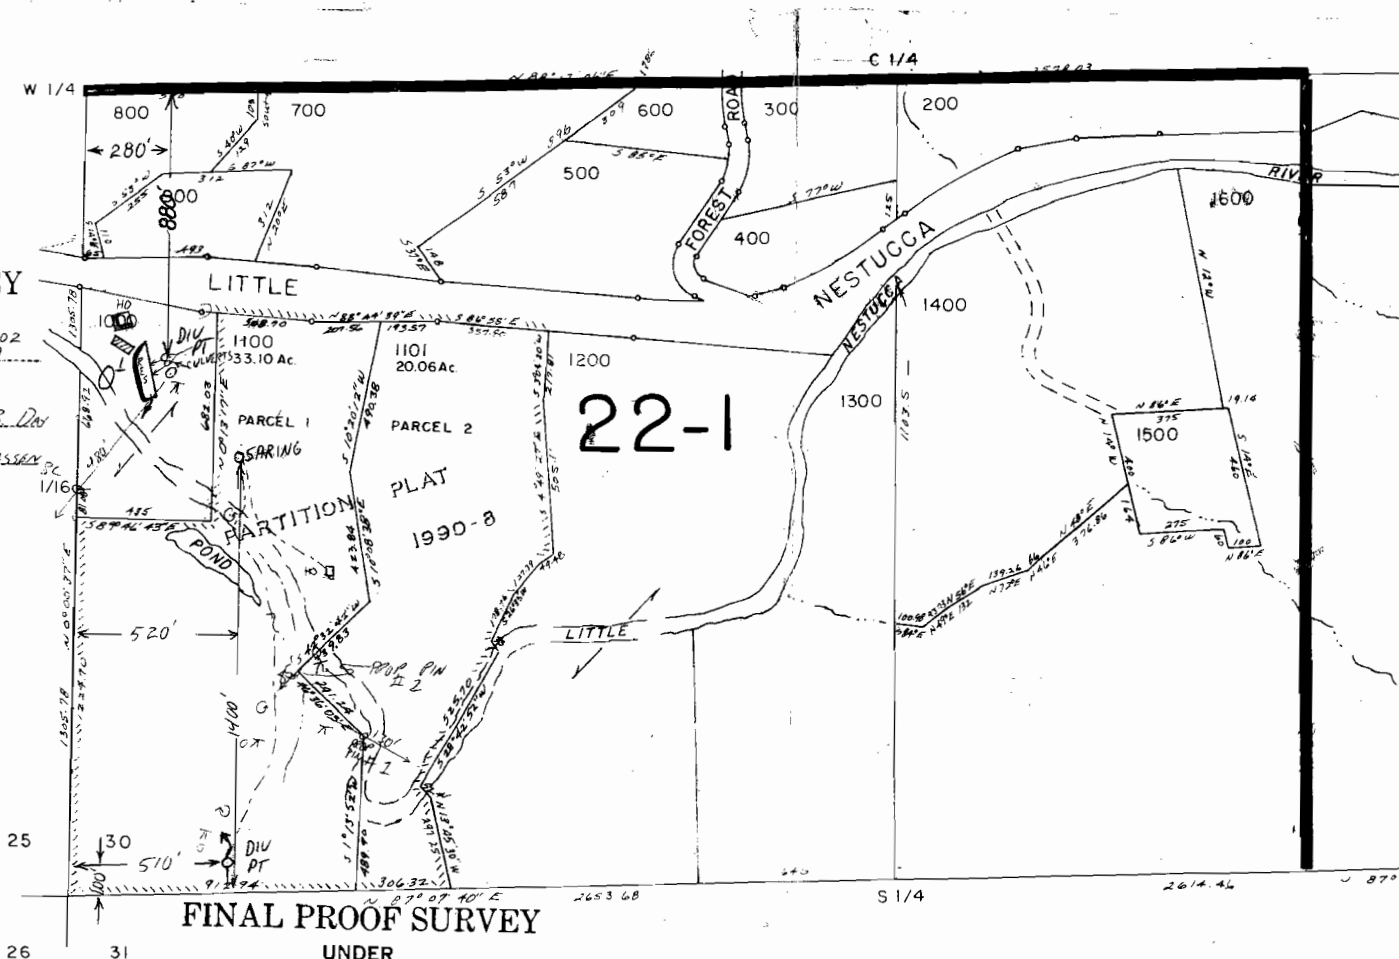

RECEIVED

APR 06 2006

WATER RESOURCES DEPT
SALEM, OREGON

FINAL PROOF SURVEY

UNDER

Application No. 69181 Permit No. 50084

IN NAME OF

ROBERT L. BAIRD

SEE MAP 5S 9