
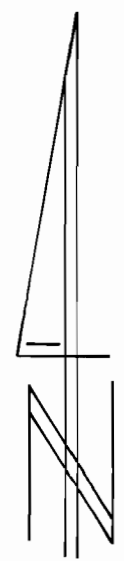


T. 6 S., R. 9 W., W.M.

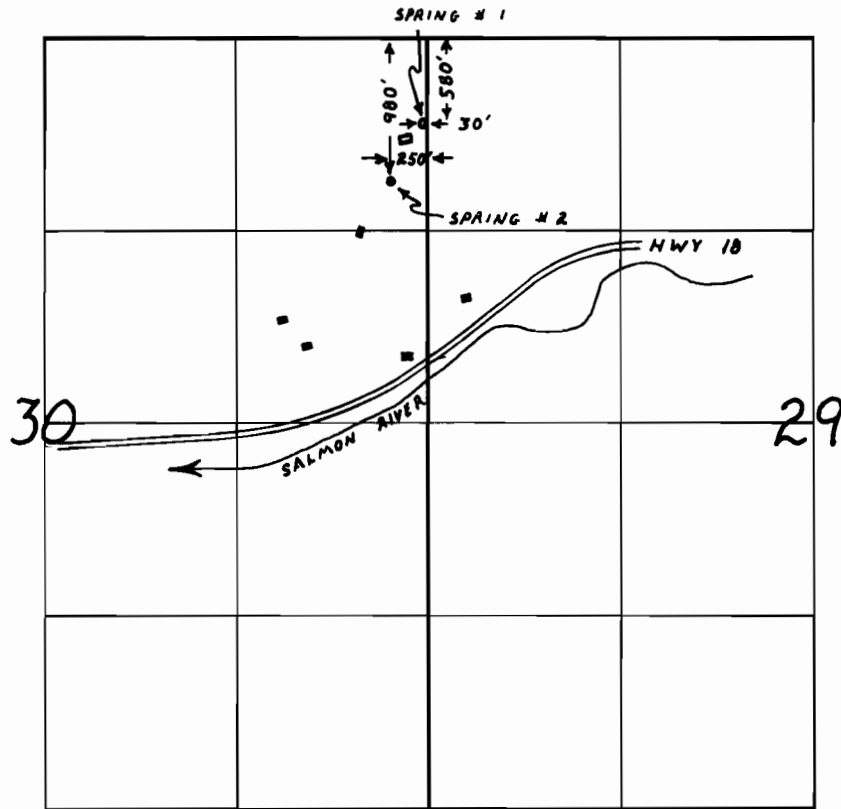

1" = 1320'

□ HOUSE USING SPRING # 1
■ HOUSES USING SPRING # 2

FINAL PROOF SURVEY

UNDER

Application No. 50792 Permit No. 38352

IN NAME OF

Mack M. Kimberling

Surveyed November 8, 1993, by R.W. Klassen