


T. 6 S., R. 10 W., W.M.

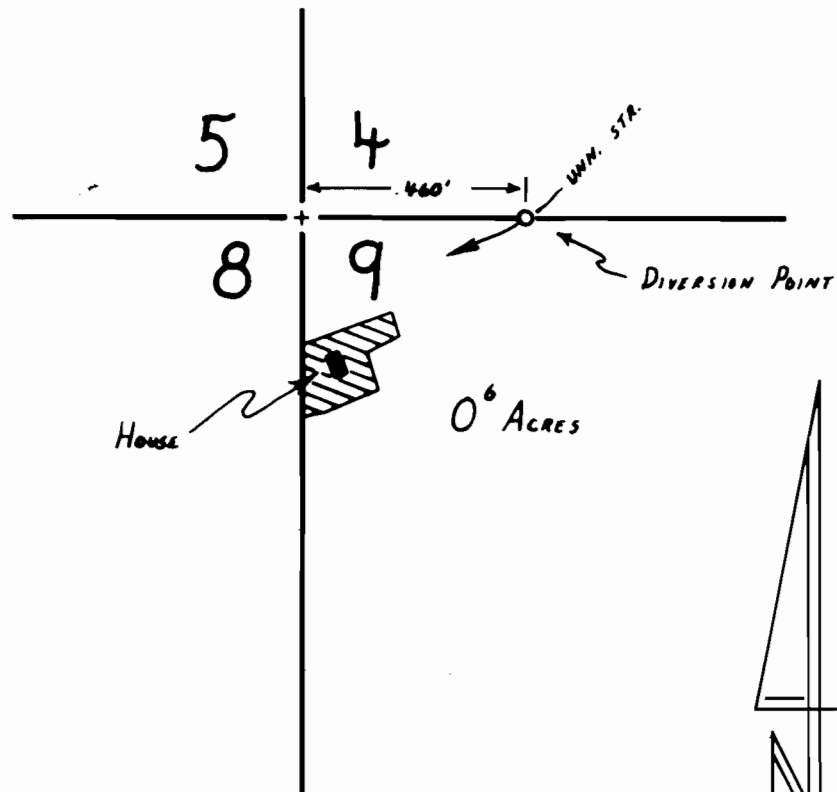

1" = 400'

FINAL PROOF SURVEY

UNDER

Application No. 61158 Permit No. 45505
IN NAME OF

CECIL E. OSBORNE JR. & CATHERIN RAE OSBORNE

Surveyed SEPTEMBER 21, 1992, by R.W. Klassen