


T. 6S., R. 10W., W.M.

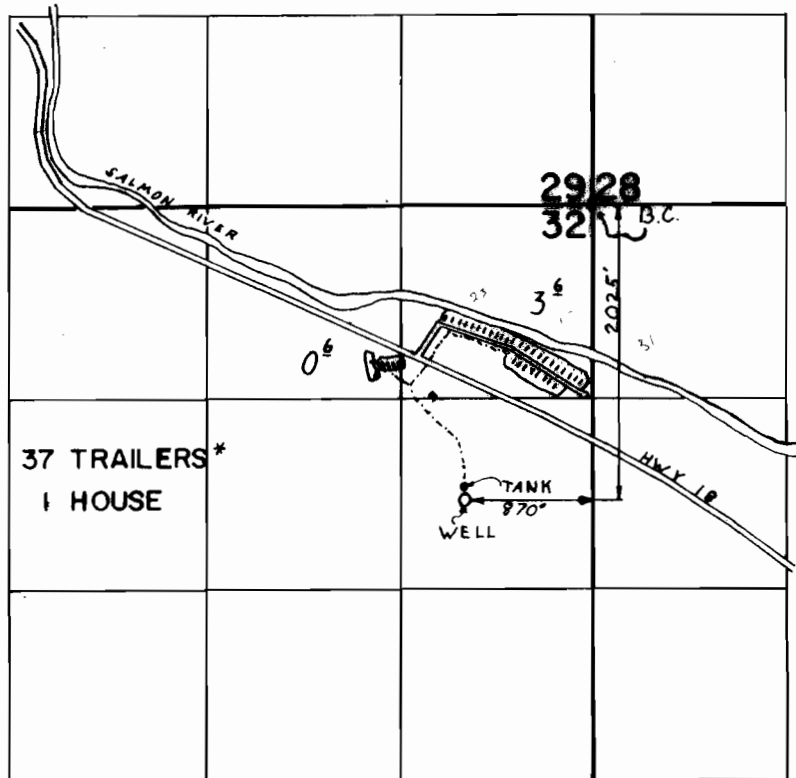

* 31 TRAILERS ARE SERVICED UNDER PERMIT G-5613

FINAL PROOF SURVEY UNDER

Application No. G-8780 Permit No. G-8316
IN NAME OF

ELDON W. HERINGER

Surveyed July 14 1992, by R. W. KLASSEN