
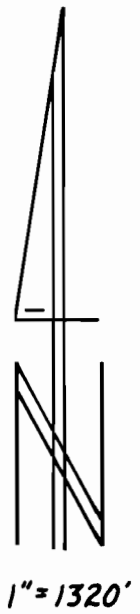


T. 1 N., R. 9 W., W.M.

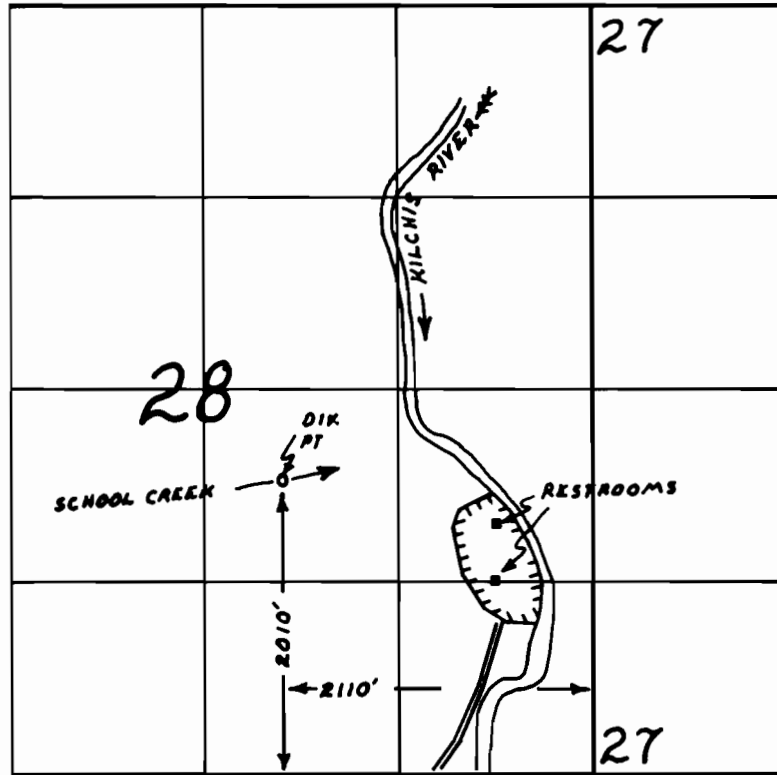

 MARK WATER USE AREA

FINAL PROOF SURVEY

UNDER

Application No. 59007 Permit No. 44589
IN NAME OF

Tillamook County Parks Department

Surveyed May 4, 1994, by R.W.Klassen