


COLUMBIA COUNTY

THIS MAP HAS BEEN PREPARED FOR ASSESSMENT PURPOSES ONLY

Scale: 1" = 400' Current Revision Date: 9 / 7 / 90

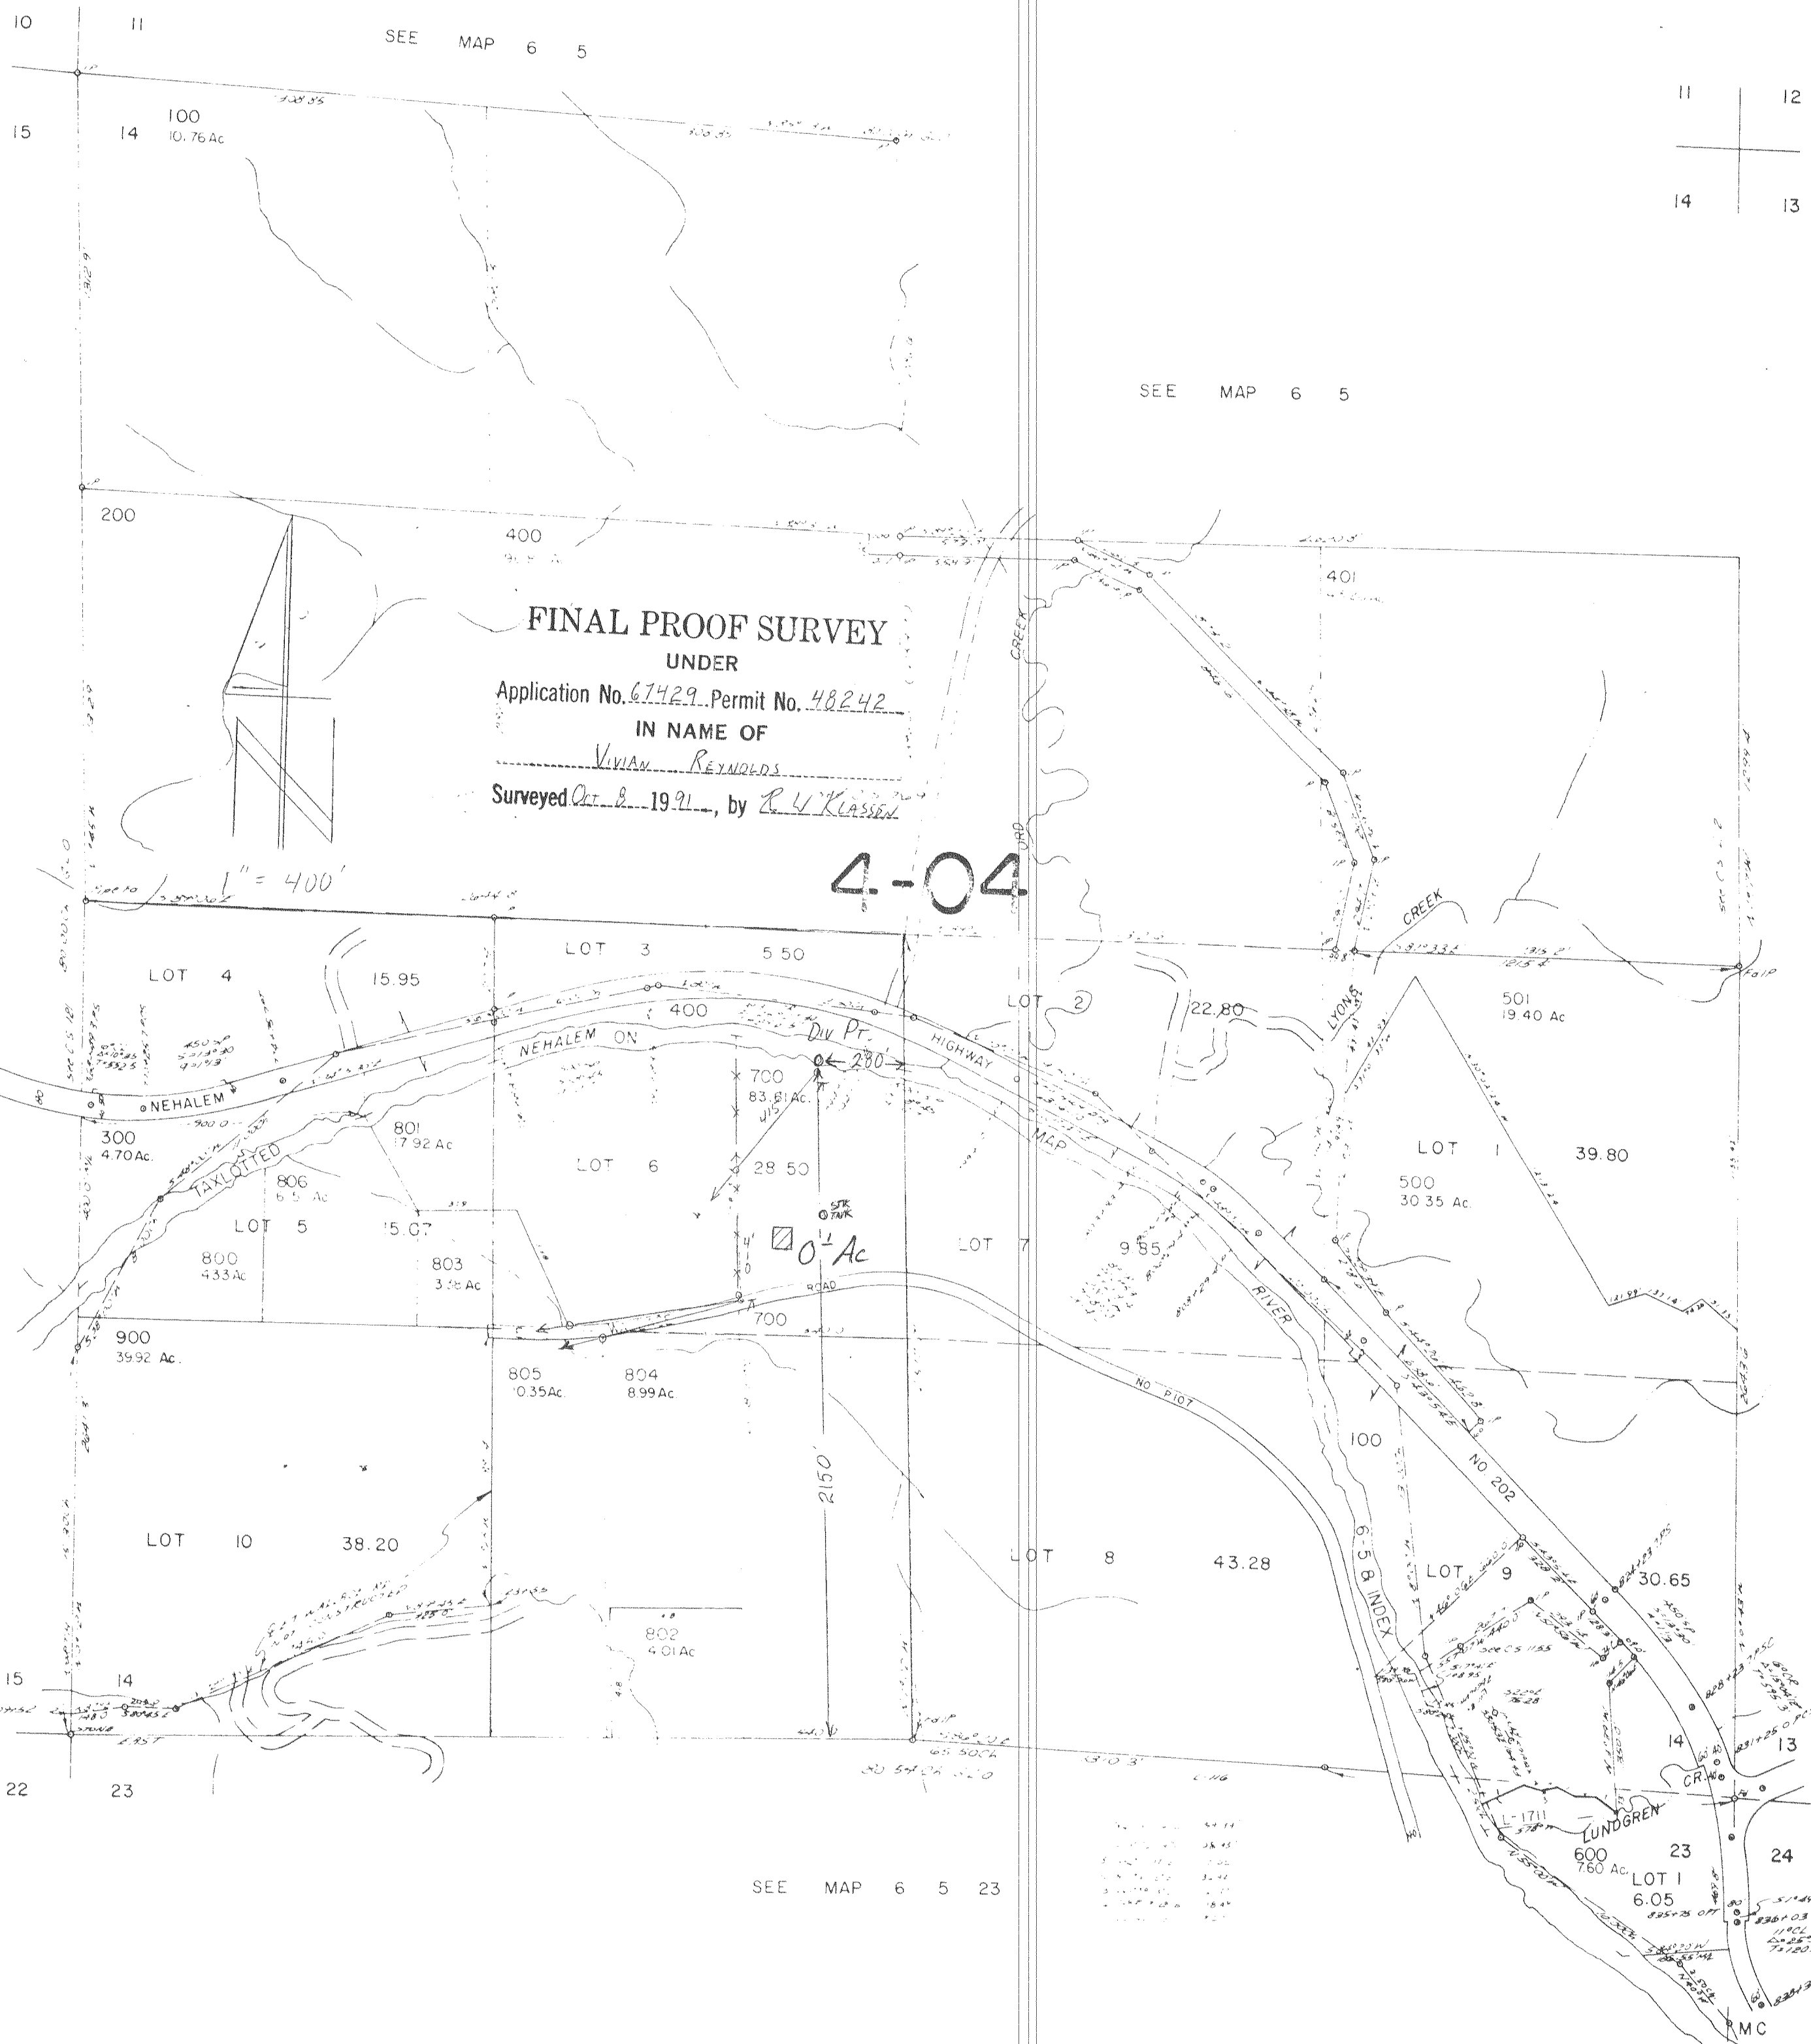

FINAL PROOF SURVEY

UNDER

Application No. 67429 Permit No. 48242

IN NAME OF

VIVIAN REYNOLDS

Surveyed Oct. 8, 1991, by R. V. KLASSEN

4-04

SEE MAP 6 5

SEE MAP 6 5

11	12
14	13

SEE MAP 6 5 13

SEE MAP 6 5 15

SEE MAP 6 5 13 3

SEE MAP 6 5 23