
SECTION 19 T.4N. R.4W W.M.
COLUMBIA COUNTY

THIS MAP HAS BEEN PREPARED FOR ASSESSMENT PURPOSES ONLY
Scale: 1" = 400' Current Revision Date: 03/04/87

SEE MAP 4 4 18

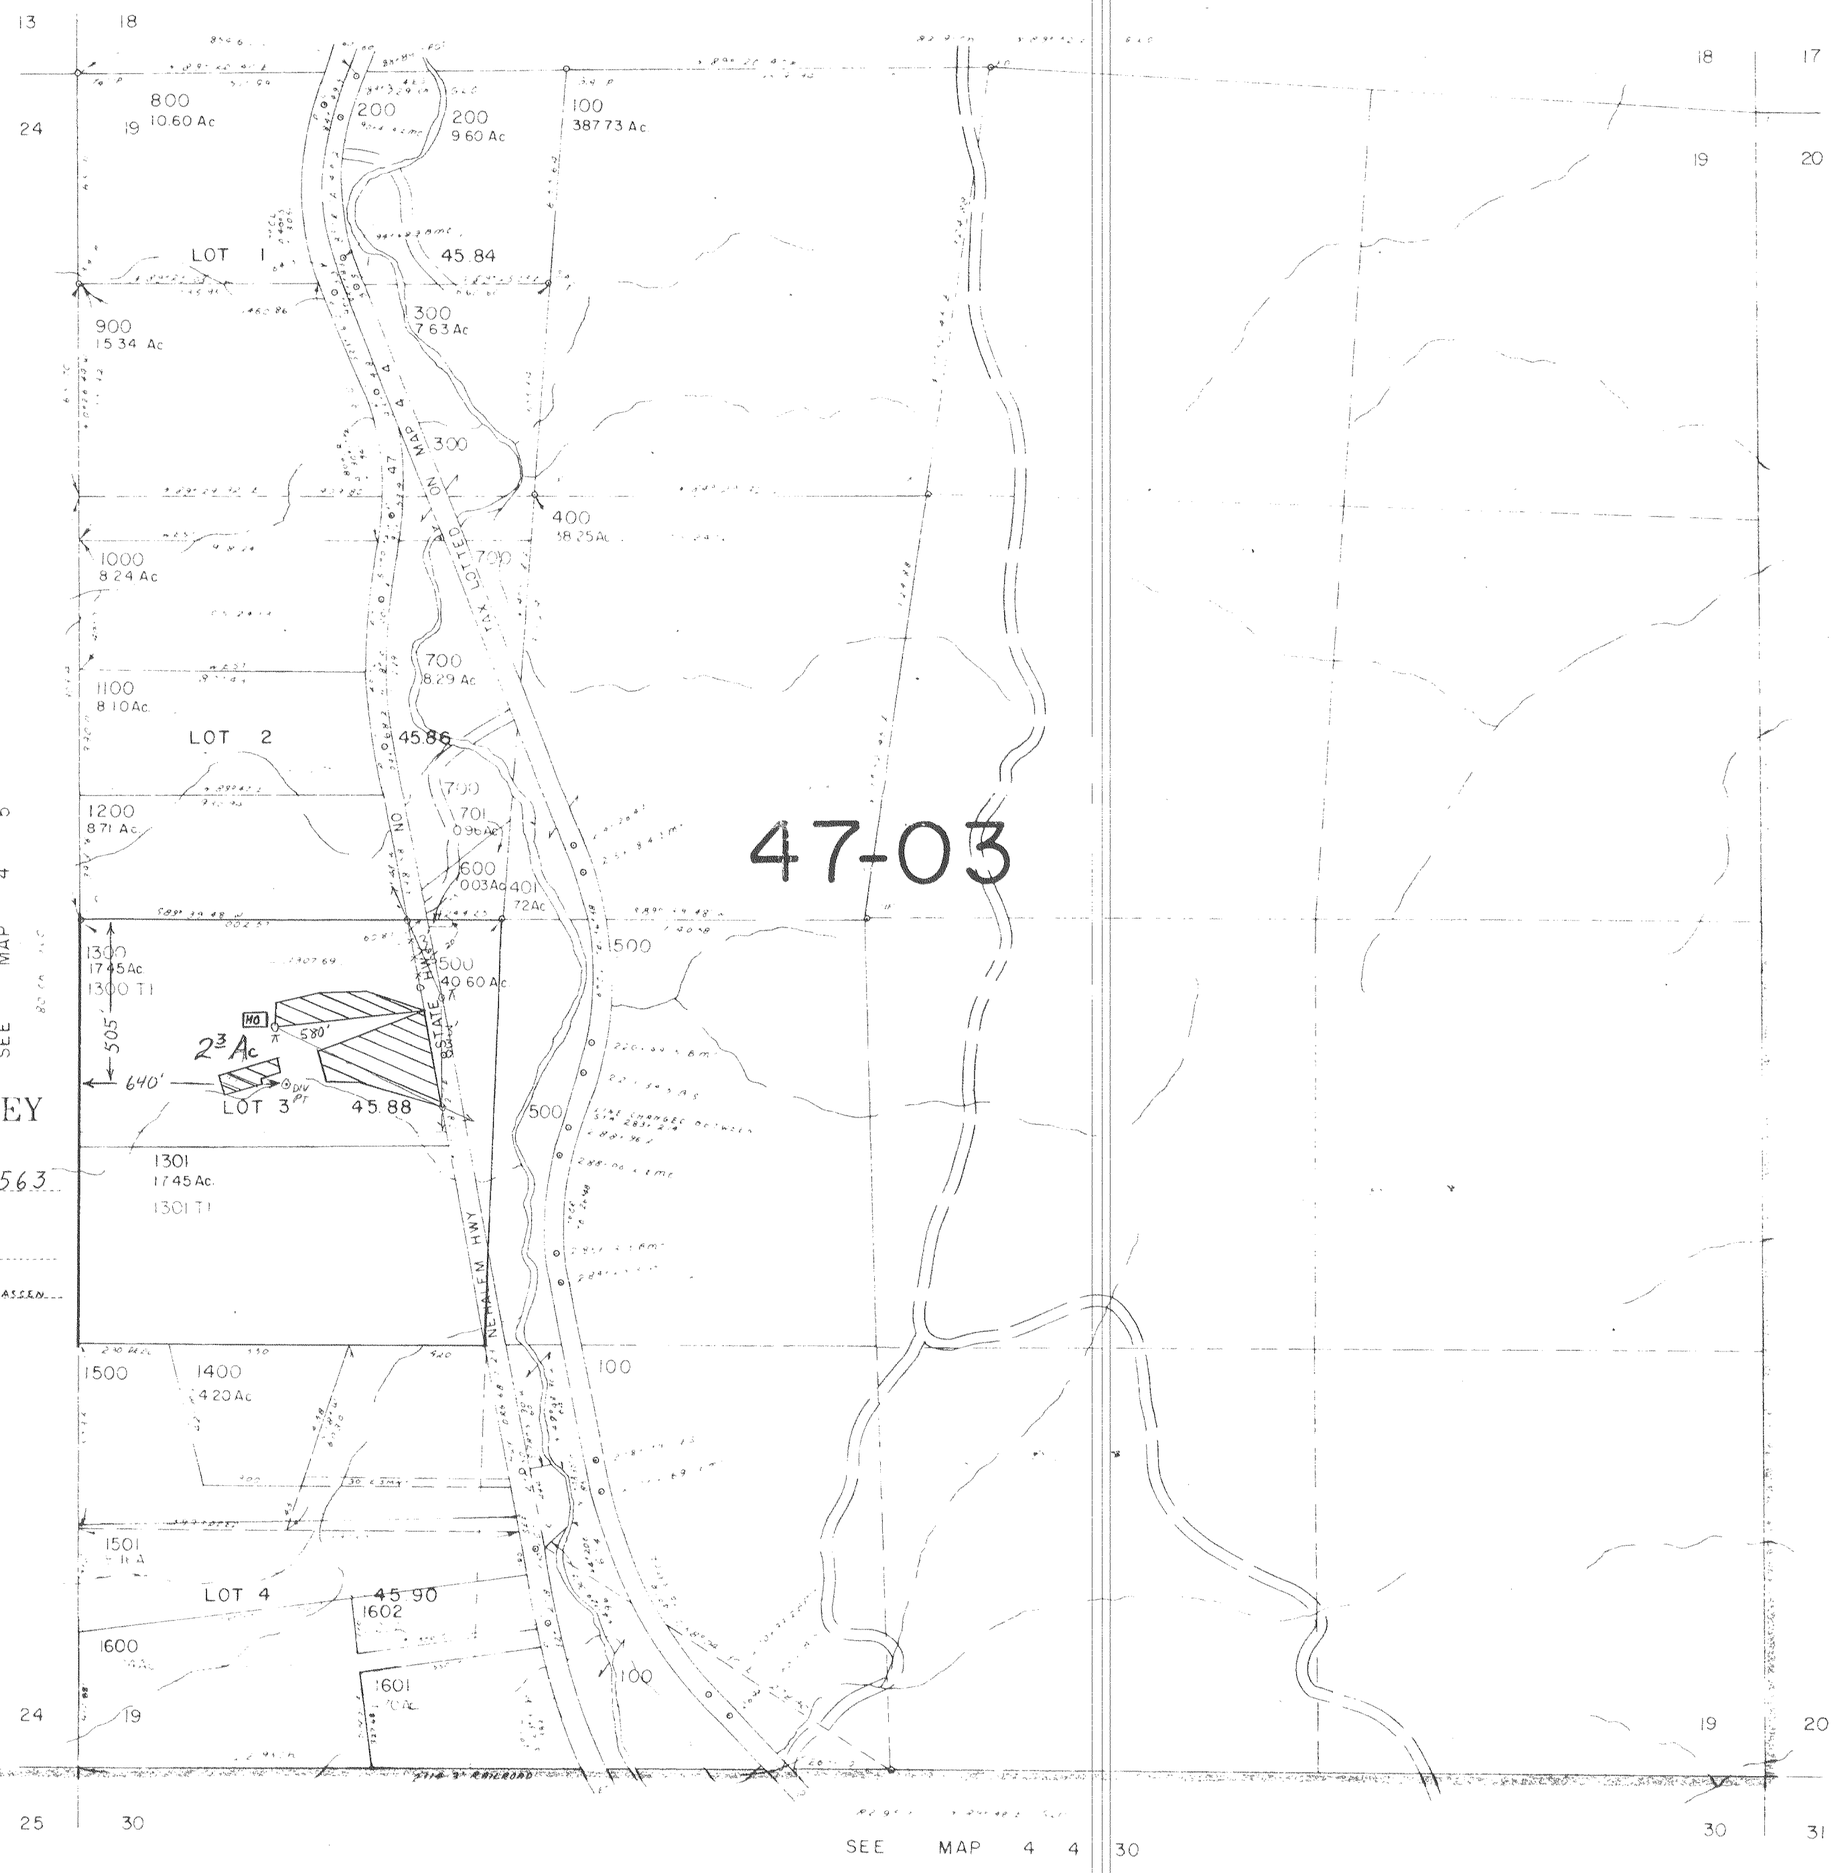

47-03

FINAL PROOF SURVEY
UNDER
Application No. 65074 Permit No. 47563
IN NAME OF
M. P. & Heather A. Johansen
Surveyed Oct. 8, 1991, by R. W. Klassen

1" = 400'