



T. 5 N., R. 9 W., W.M.

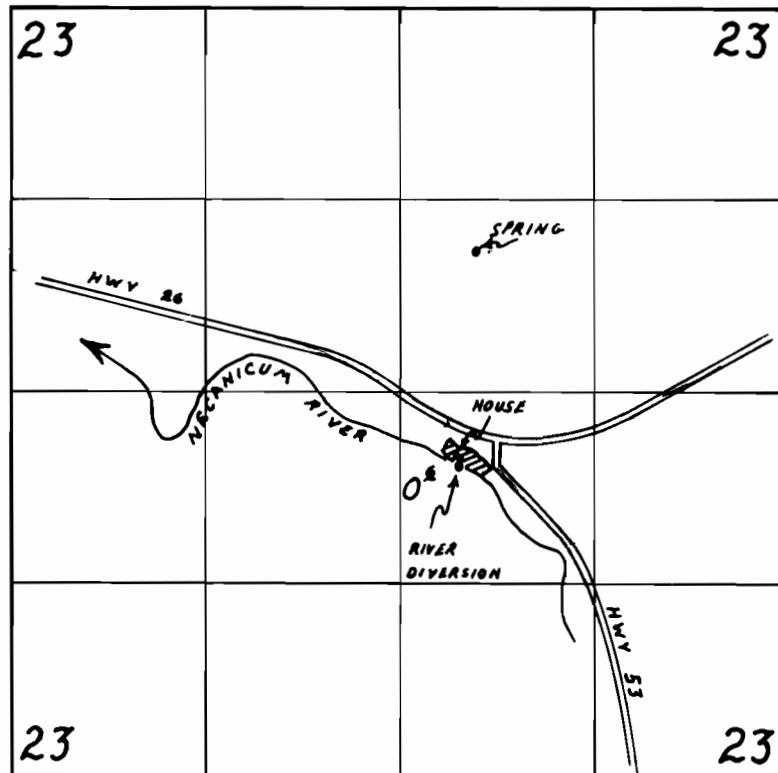

SPRING LOCATED 970' N & 2130' W; RIVER DIVERSION LOCATED 510' S & 2250' W; BOTH FROM THE EAST 1/4 CORNER

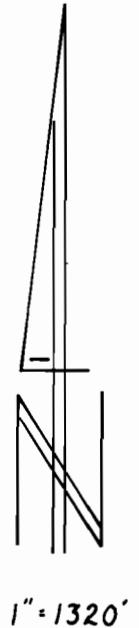

FINAL PROOF SURVEY

UNDER

Application No. 68343 Permit No. 49360
IN NAME OF

Mabel Belscamper

Surveyed November 30, 1993, by R.W. Klassen