


T. 6 S., R. 10 W., W.M.

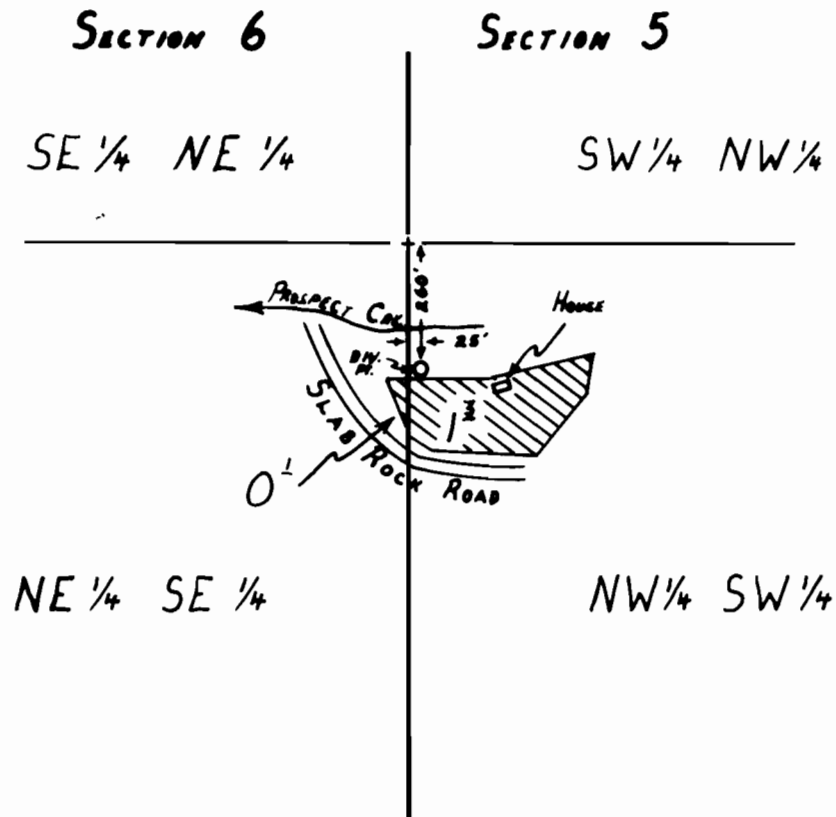

FINAL PROOF SURVEY

UNDER

Application No. 56038 Permit No. 42181

IN NAME OF

BOB SWARTZ

Surveyed SEPTEMBER 21, 1992, by R.W. Klassen