


T-8894

TRANSFER APPLICATION MAP
FOR RON ROBINS
CHANGING POINT OF DIVERSION
FORMALLY CERT 122 & T-6228
T2N, R23E WM

RECEIVED

SEP 19 2001

WATER RESOURCES DEPT.
SALEM, OREGON

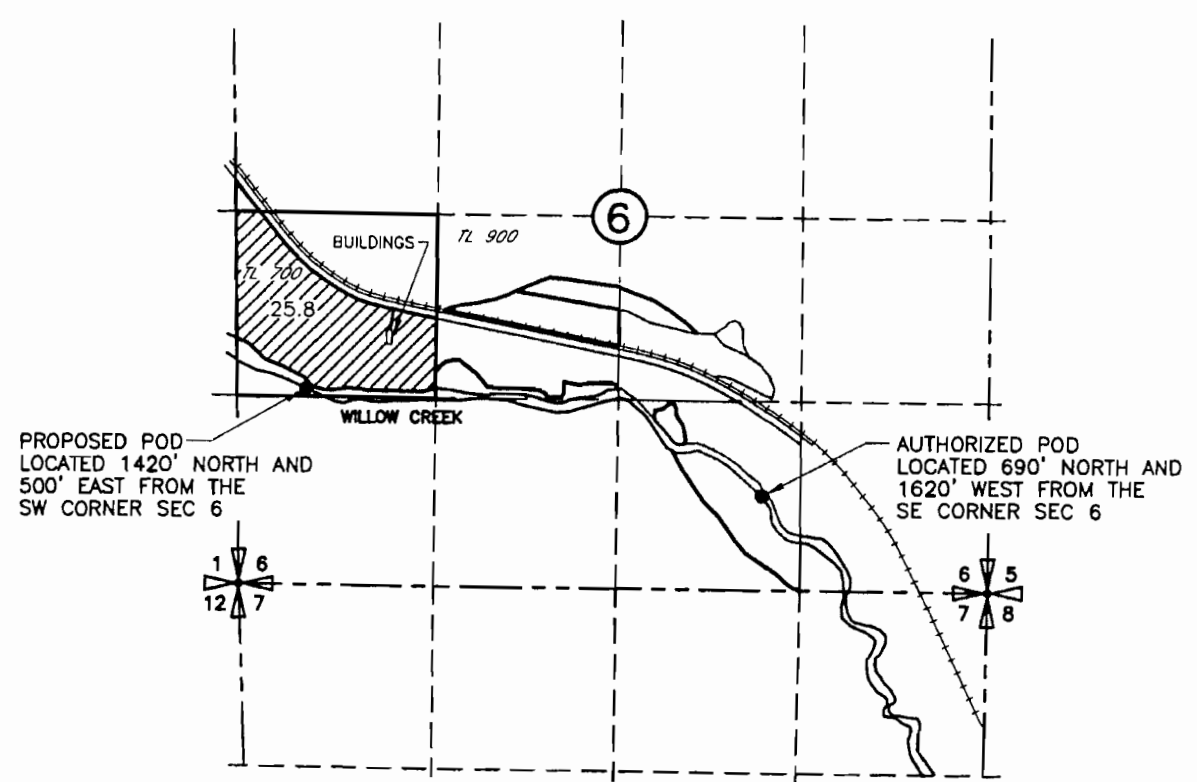


PROPOSED POD
LOCATED 1420' NORTH AND
500' EAST FROM THE
SW CORNER SEC 6

AUTHORIZED POD
LOCATED 690' NORTH AND
1620' WEST FROM THE
SE CORNER SEC 6



 25.8 AC AREA WITH WATER RIGHTS

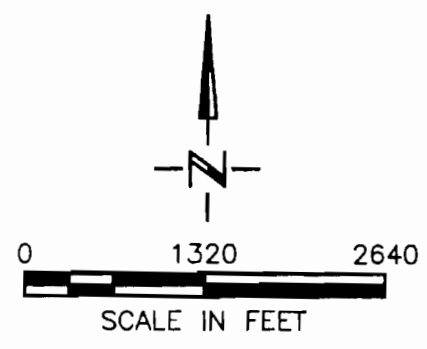

Certified Water Right Examiner
#333 WRE
Dale G. VanSchoiack
Dale G. VanSchoiack
May 19, 1992
9/12/01
STATE OF OREGON

NOTE:
THE PURPOSE OF THIS MAP IS TO IDENTIFY THE APPROXIMATE LOCATION
OF THE WATER RIGHT. IT IS NOT INTENDED TO PROVIDE INFORMATION
RELATIVE TO THE LOCATION OF PROPERTY OWNERSHIP BOUNDARY LINES.

9/12/01
3522.142
3522142.dwg