

SEC PLAT

T 25 S

R 24 E

SEC 19, 20, 21, 28, 29, 32, 33


T 26 S

R 24 E

SEC 4, 5, 9, 10, 15, 16, 17, 22

RESERVOIRS SHOWN ON
MAP COVERED UNDER
OTHER PERMITS

Application No. 58465
Permit No. 47163

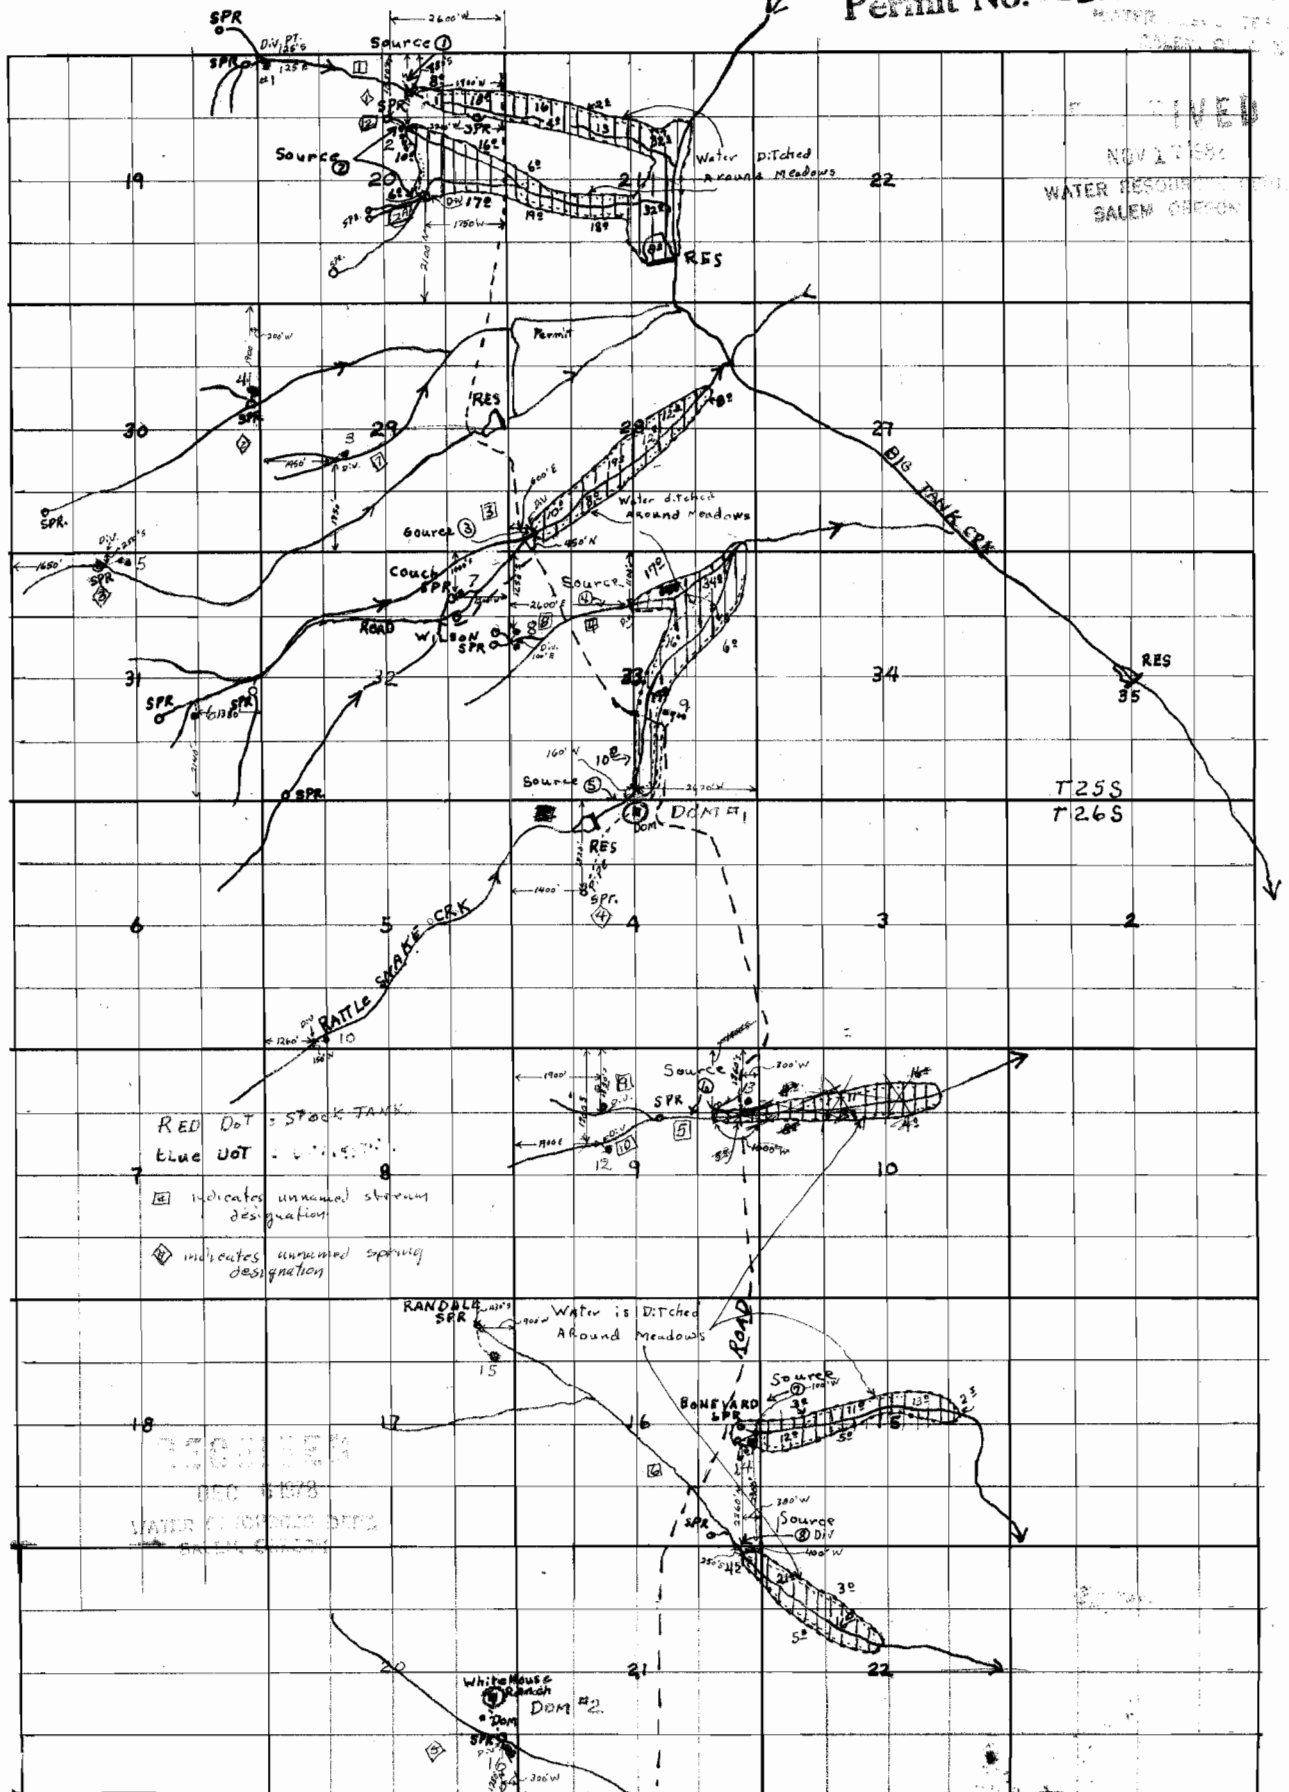

R 24 E

2" = 1 MILE