


T. 1 & 2 S. R. 13 E. W.M.

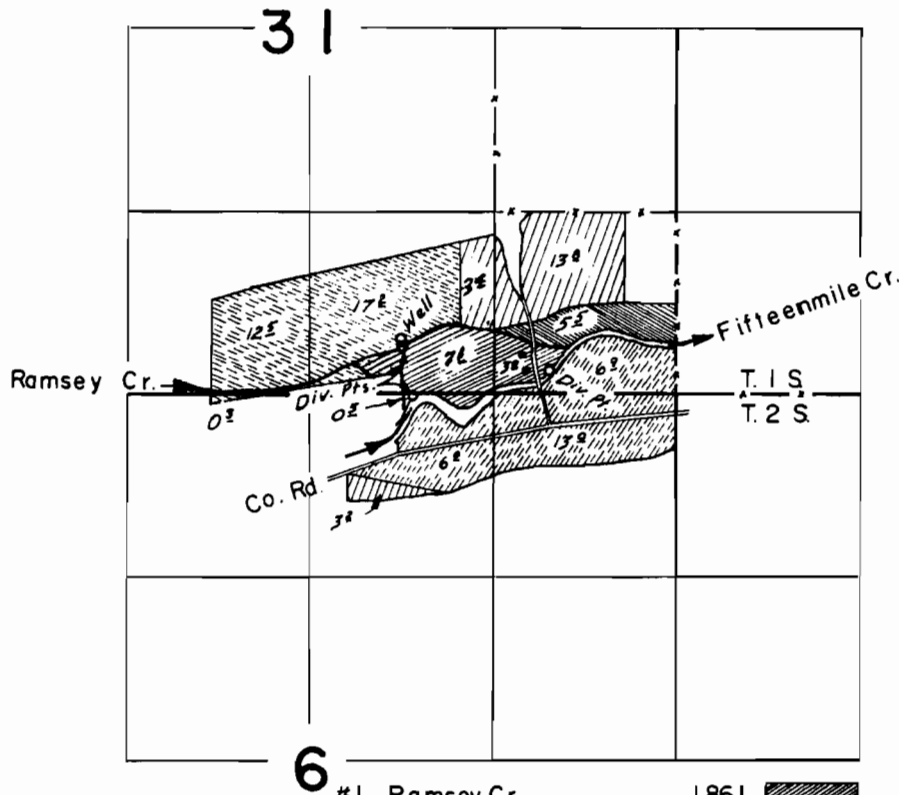

- | | | | |
|----|-----------------|------|--|
| #1 | Ramsey Cr. | 1861 | |
| #2 | Ramsey Cr. | 1866 | |
| #3 | Fifteenmile Cr. | 1867 | |
| #4 | Fifteenmile Cr. | 1912 | |
| #5 | Well, Primary | 1960 | |

FINAL PROOF SURVEY

UNDER

Transfer No. N-25 Ramsey Cr.

Transfer No. M-128 Fifteenmile Cr.

G-1903

G-1741 Suppl. to #1,2,3 & 4

Application No. 37672 Permit No. 28078 Suppl. to #1,2 & 5

IN NAME OF

HARVEY & LUCY McALLISTER

Surveyed Dec. 11 1962, by *S. W. Jelousek*