


T.18S., R.2W., W.M.

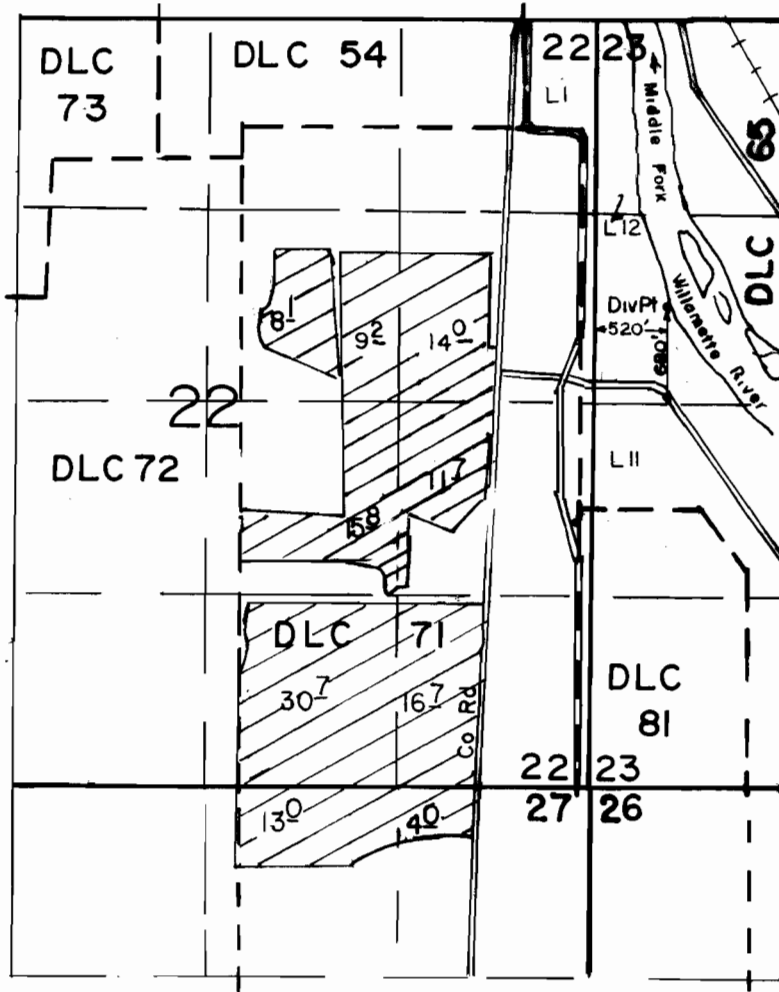

FINAL PROOF SURVEY
UNDER

Application No. 64845. Permit No. 47634.....
IN NAME OF

.....WALTER A. SPRAGUE.....

Surveyed MAY 18 92 by RW KLASSEN
JUNE 7 1990., by T.M. WARREN.....