


T 20S R 5W WM

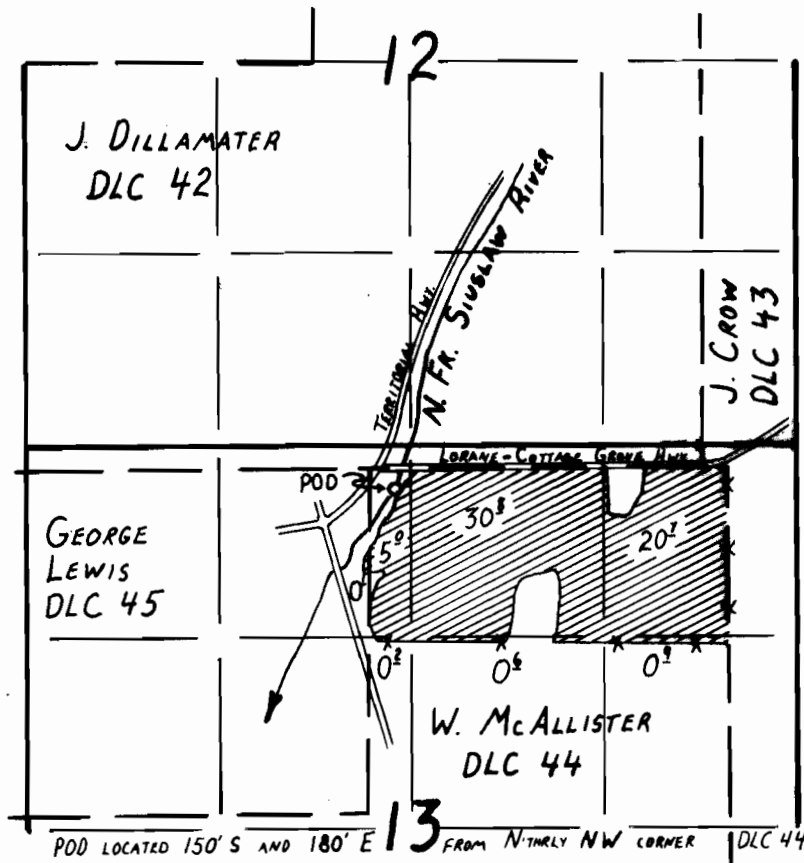

FINAL PROOF SURVEY UNDER

Application No. 65218.. Permit No. 47877....
IN NAME OF

GARY A. OR BETTY A. WILLOUGHBY.....

Surveyed Aug. 28.. 1990.., by T.M. WARREN.....