



# T. 17 S., R. 2 W., W.M.

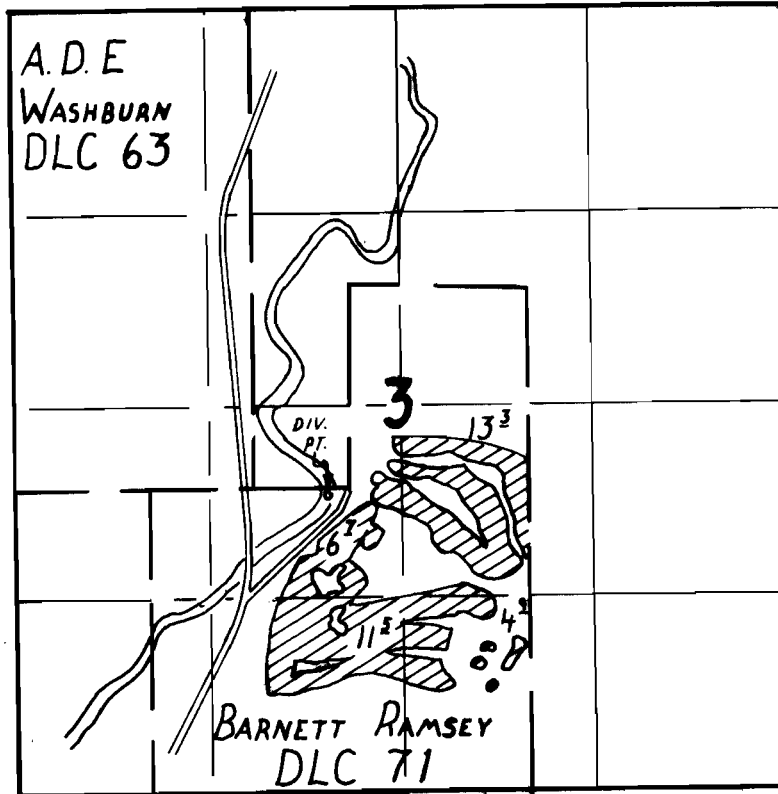

THE DIVERSION POINT IS LOCATED 60 FT. E. & 150 FT. W. FROM THE BESTLY INT. COR. DLC 71

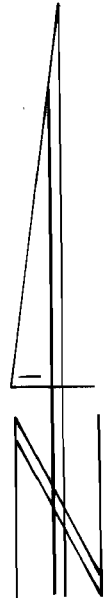

1" = 1320'

## FINAL PROOF SURVEY

UNDER

Application No. 65818 Permit No. 47707  
IN NAME OF

SPRINGFIELD COUNTRY CLUB

Surveyed MAY 18, 1992, by R.W. Klassen