


T. 13 S., R. 5 W., W.M.

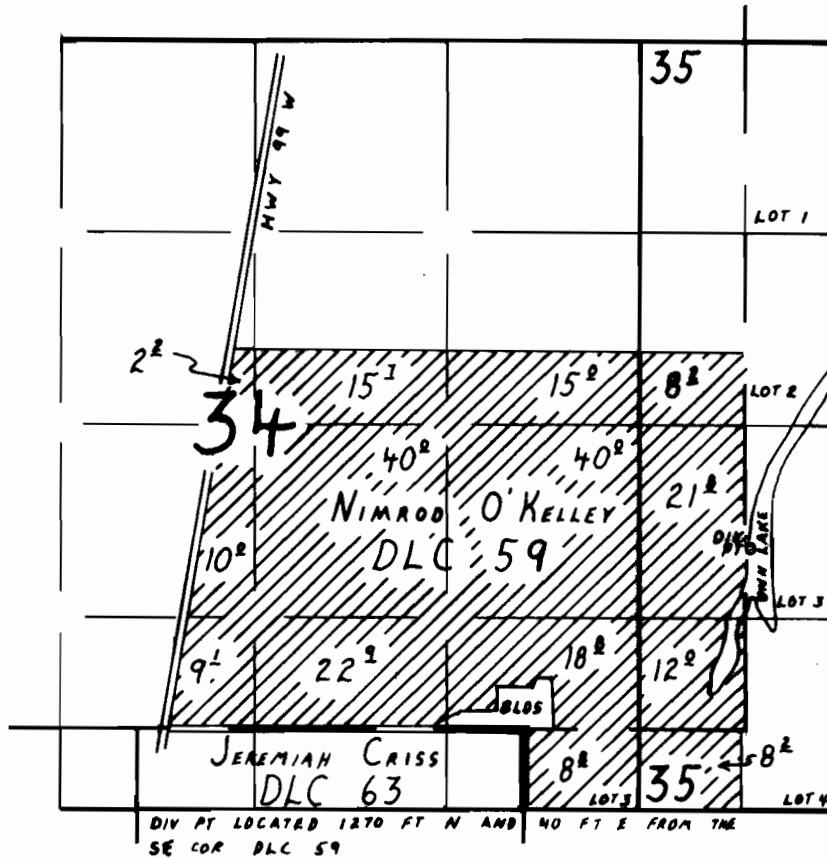

FINAL PROOF SURVEY

UNDER

Application No. 69131 Permit No. 50211

IN NAME OF

C. M. HUBBARD

Surveyed JULY 30, 1992, by R.W. KLASSEN

3/2/06 YMS

WAC 900R 2 123 RWX 12/92