
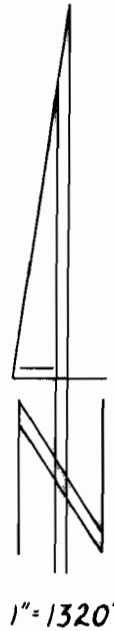


# T. 10 S., R. 2 W., W.M.

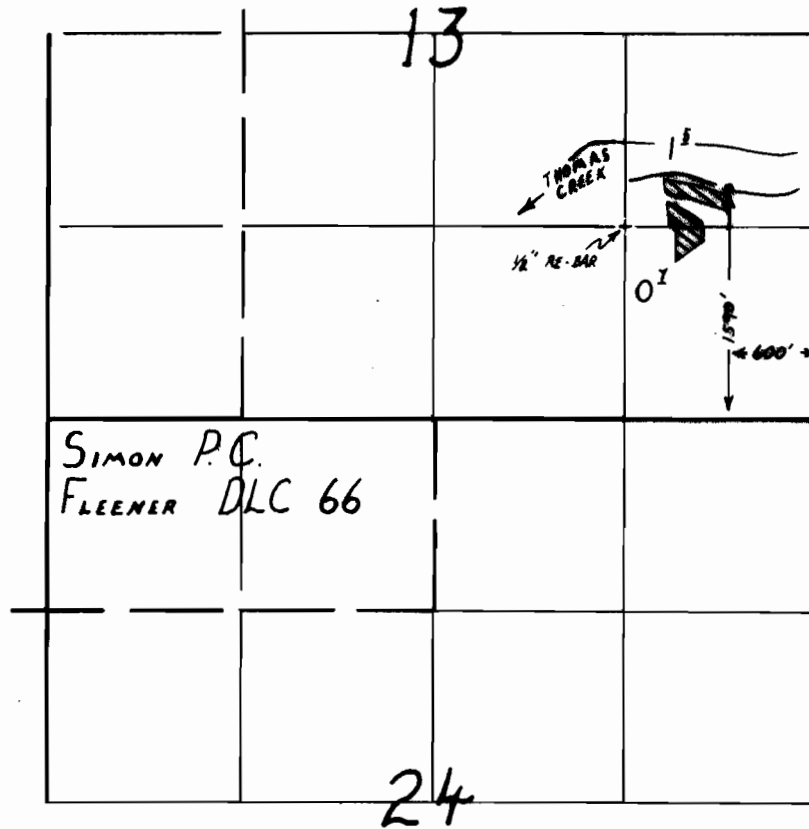

## FINAL PROOF SURVEY

UNDER

Application No. 65211 Permit No. 47655

IN NAME OF

GAIL G. GROVE, JR.

Surveyed APRIL 12, 1991, by R.W. Klassen