


T. 20 S., R. 4 & 5 W., W.M.

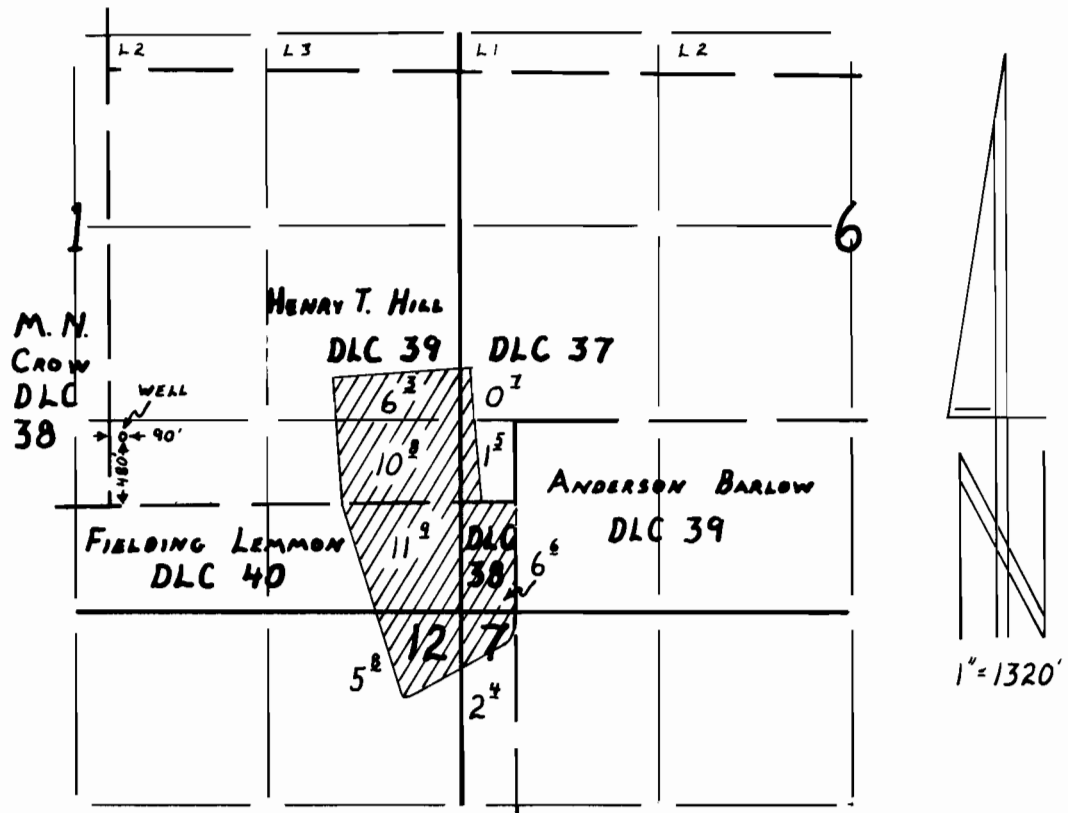

FINAL PROOF SURVEY

UNDER

Application No. G-11657 Permit No. G-10865
IN NAME OF

KESTER RANCH

Surveyed MAY 19, 1992, by R.W. Klassen