


T. 11S. R. 2W. W.M.

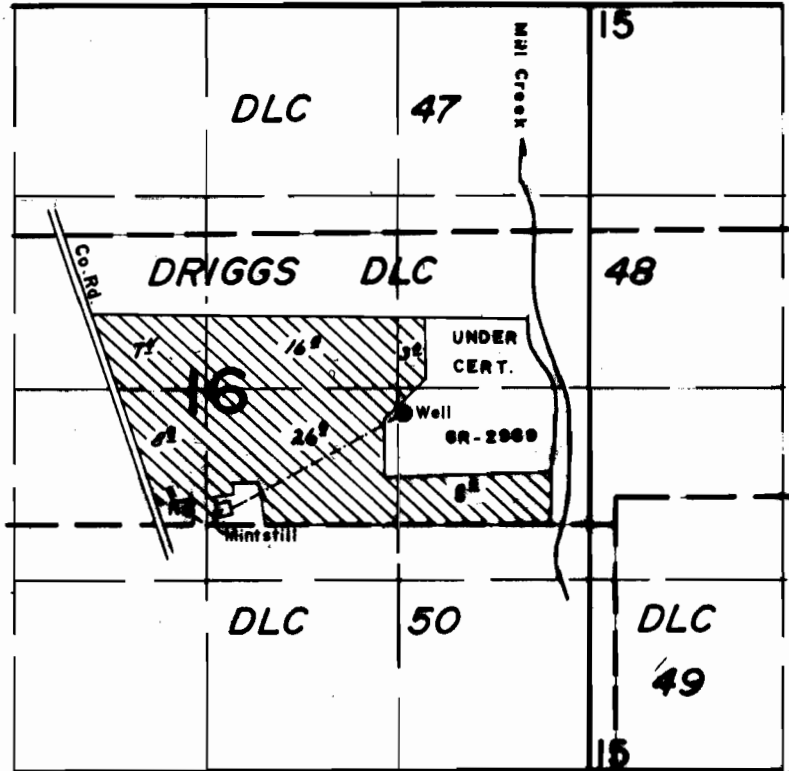

Well Loc - 2838 S. 1/2 125' W. from NE. Cor. Sec. 16

FINAL PROOF SURVEY UNDER

Application No. G-7.7.2.7 Permit No. G-7.18.9.....
IN NAME OF

.....**BEATRICE & BURLE OAKLEY**.....

MAY 15 1991 R.W. KLASSEN
Surveyed July...6... 197.9, by S.C. BROWN.....