
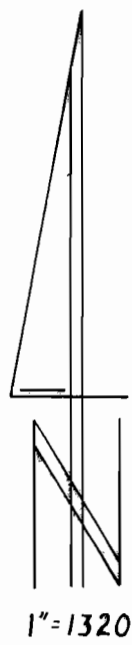


T. 17 S., R. 4 W., W.M.

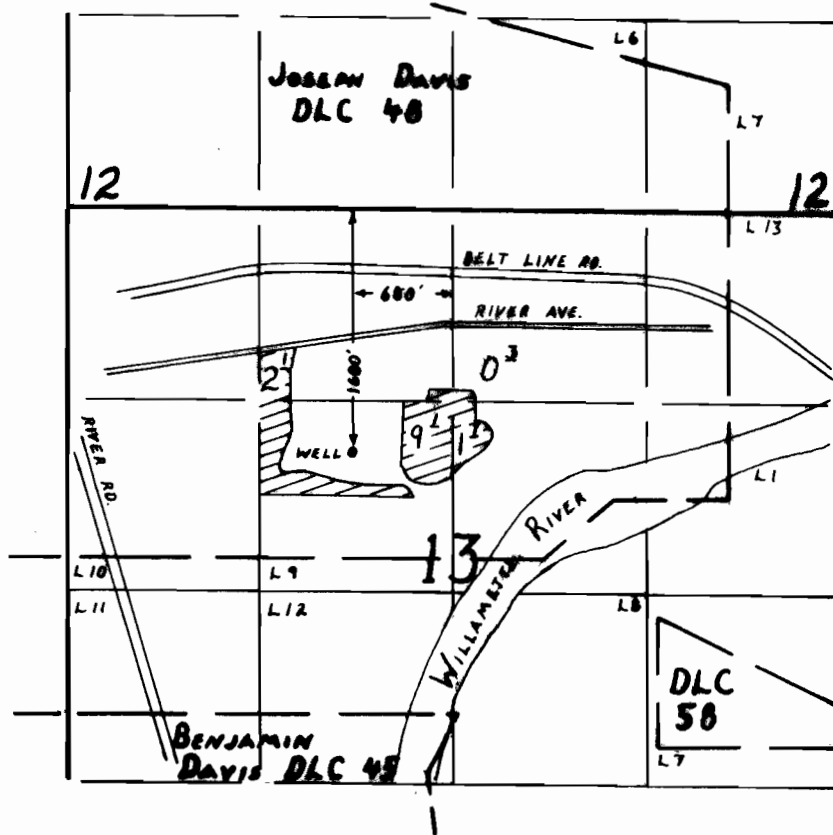

FINAL PROOF SURVEY

UNDER

Application No. G-11435 Permit No. G-10840
IN NAME OF

METROPOLITAN WASTEWATER MANAGEMENT COMMISSION

Surveyed MAY 19, 1992, by R.W. Klassen