


T.14S.,R.17E.,W.M.

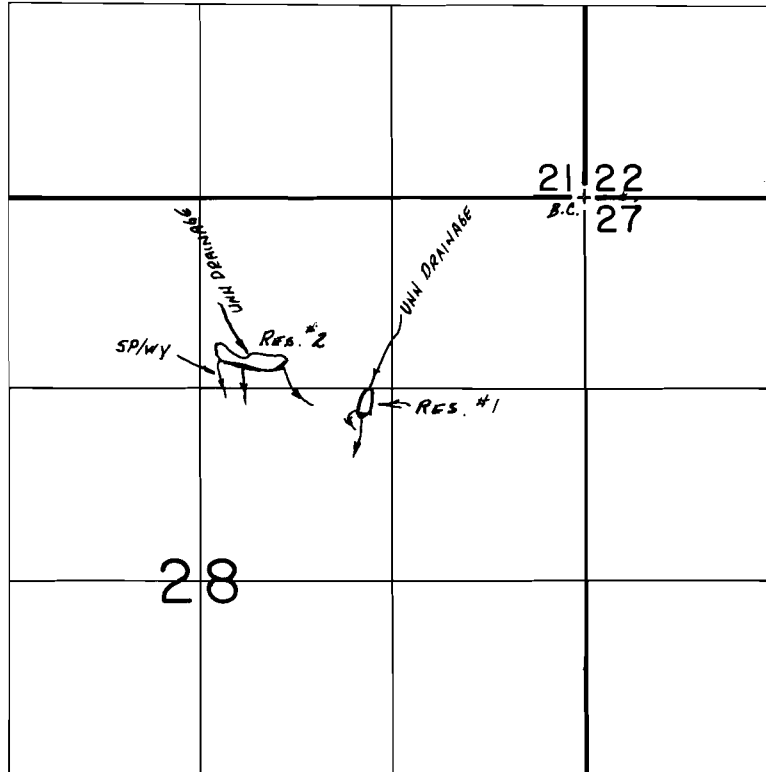

SCALE: 1" = 1320'

FINAL PROOF SURVEY UNDER

Application No. R-59902 Permit No. R-8220 RES. #2
R-59941 RES. #1
IN NAME OF

JOHN G. LAWSON

Surveyed May 10, 1991, by B.W. BISHOP