


T. 16 S., R. 23 & 24 E., W.M.

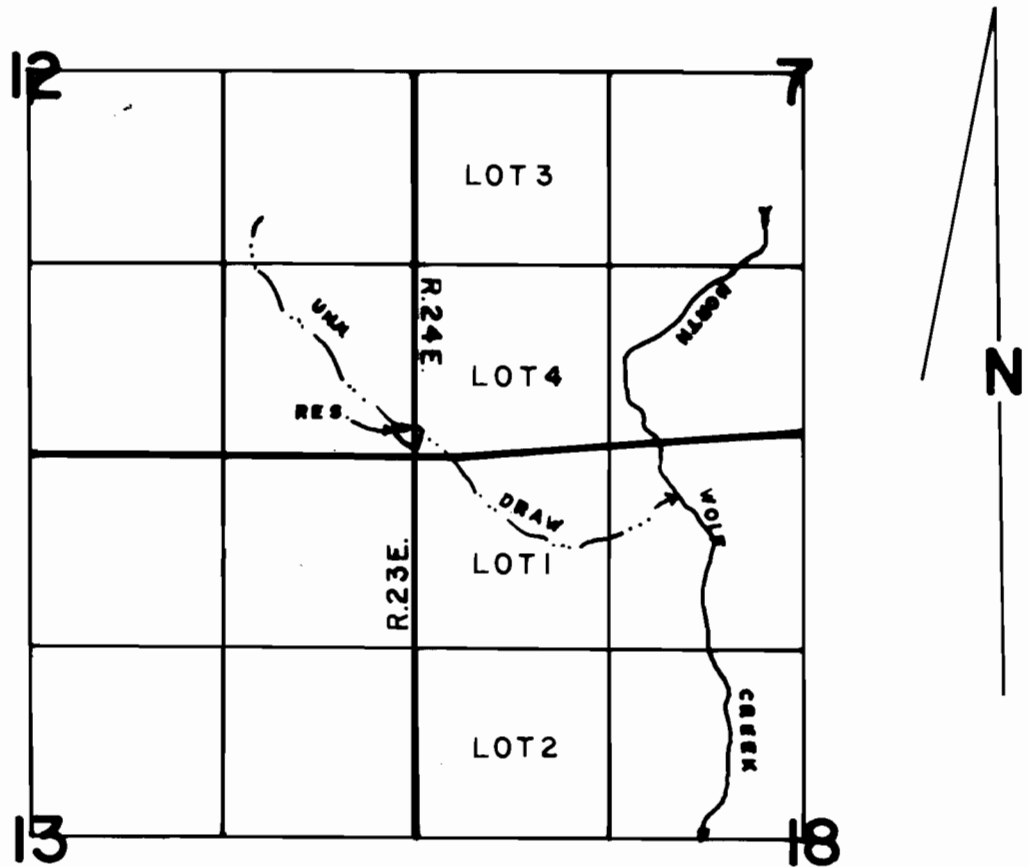

SCALE : 1" = 1320'

FINAL PROOF SURVEY
UNDER

Application No. R-62809 Permit No. R-8403
IN NAME OF

FAYNE E. RITCH

Surveyed OCT 22, 1992, by R.M.SUTTERFIELD