


T. 6N., R. 38E., W.M.

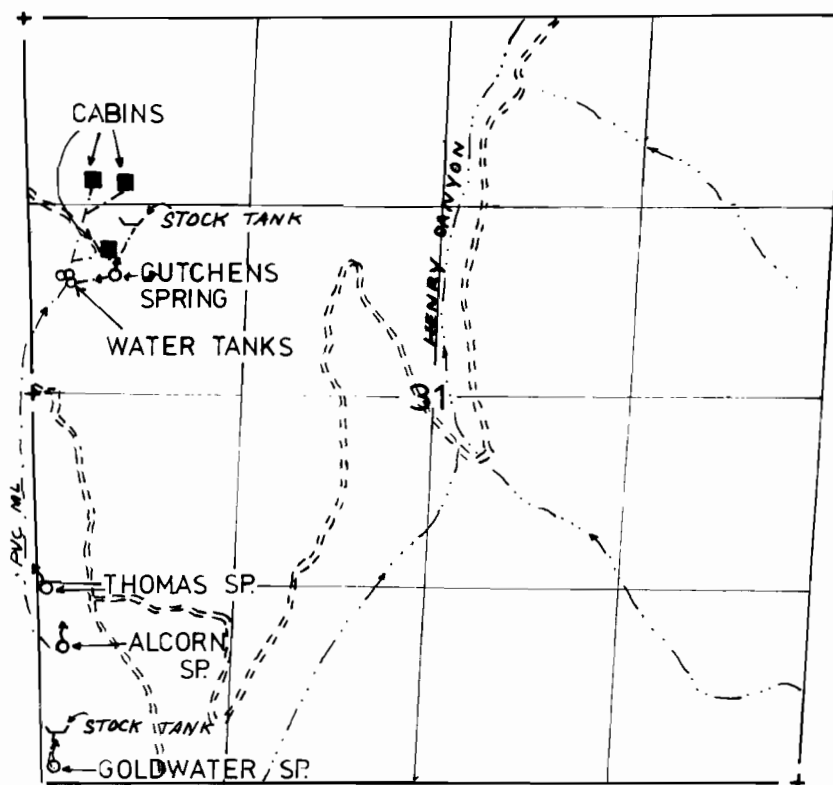

1"=1320'

POD GUTCHENS-800' N. & 570' E. FROM W. 1/4 COR. SEC. 31.
POD THOMAS-1350' S. & 60' E. FROM W. 1/4 COR. SEC. 31.
POD ALCORN-1750' S. & 150' E. FROM W. 1/4 COR. SEC. 31.
POD GOLDWATER-2570' S. & 60' E. FROM W. 1/4 COR. SEC. 31.

FINAL PROOF SURVEY UNDER

Application No. 54802 Permit No. 41367
IN NAME OF

JOHN L. LAMMERS

Surveyed Aug. 5 1992 by J. Miller