


T. 3 N., R. 36 E., W.M.

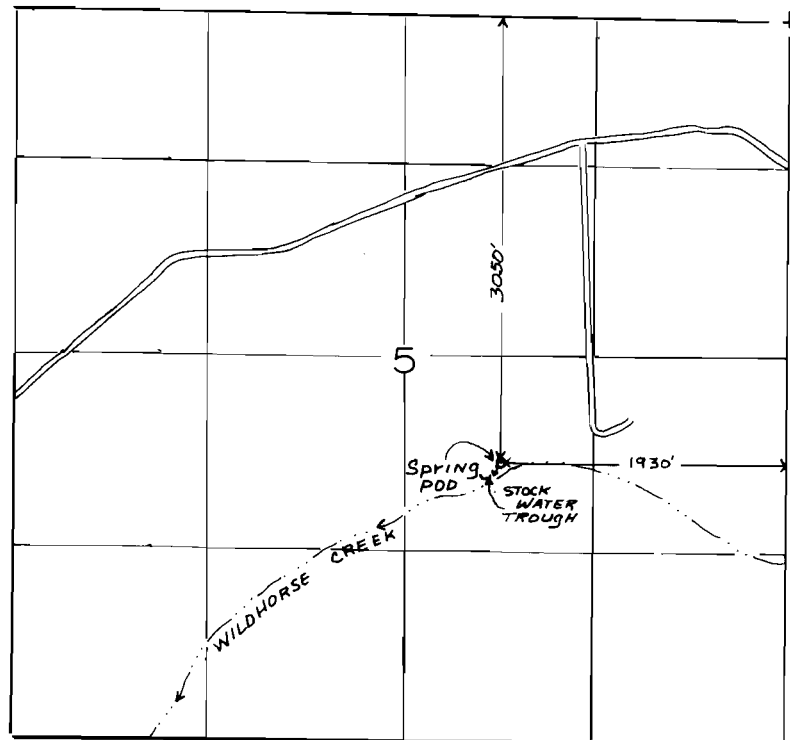

FINAL PROOF SURVEY

UNDER

Application No. 59409 Permit No. 44682

IN NAME OF

JOYCE ADAMSON

Surveyed 7-28, 1993, by J. MILLER