


T. 4 N., R. 37 & 38 E., W.M.

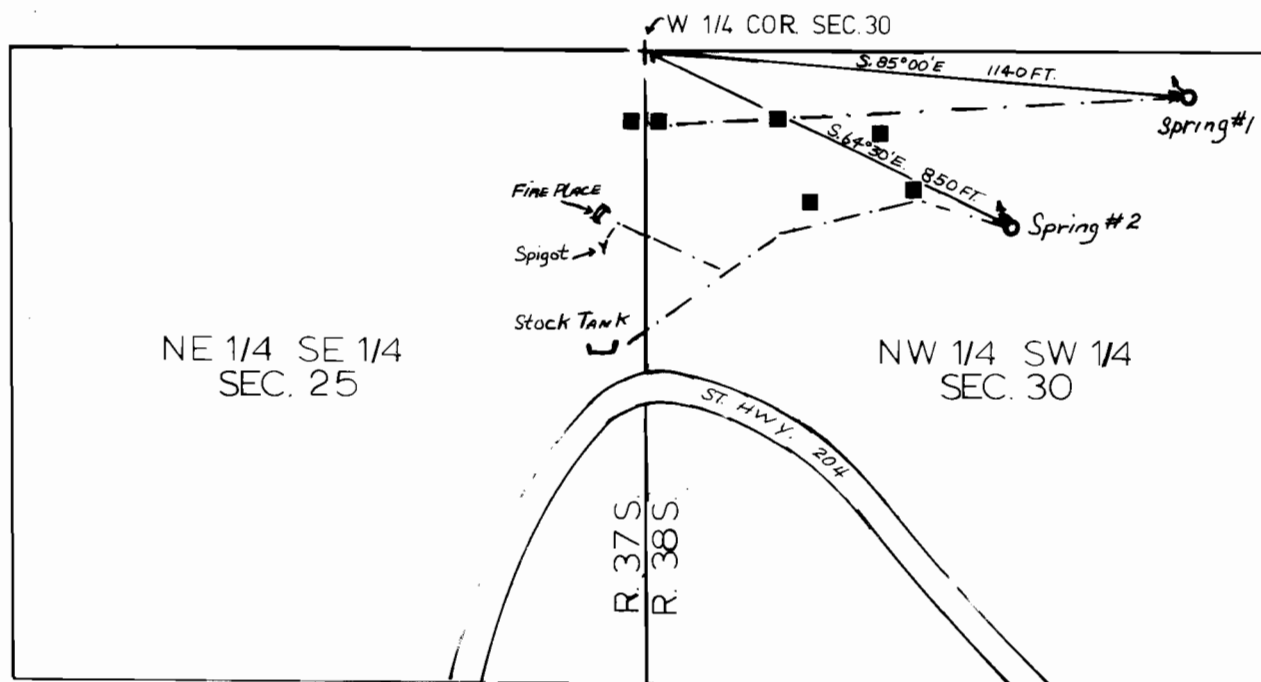

1" = 400'

FINAL PROOF SURVEY UNDER

Application No. 51294 Permit No. 38734
IN NAME OF

HILL CAMP INCORPORATED

Surveyed 7-15, 1993, by J. MILLER