


T. 4 N., R. 37 E., W.M.

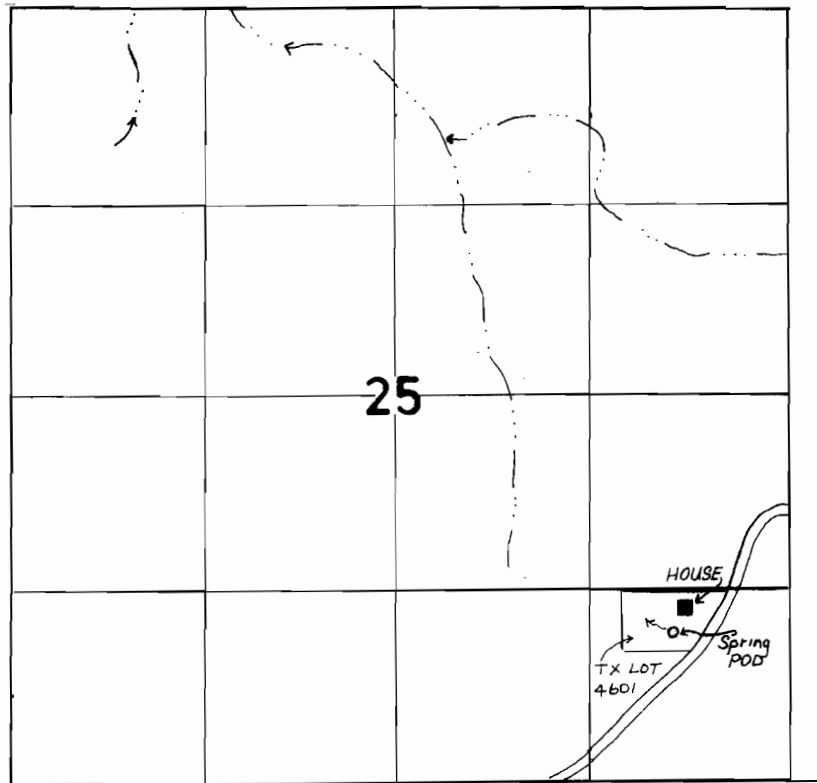

POD - 1050' N. AND 800' W. FROM S.E. COR. SEC. 25.

FINAL PROOF SURVEY
UNDER

Application No. 59228 Permit No. 44527
IN NAME OF

JAMES C. CORWIN

Surveyed 7-15, 1993, by J. MILLER