


T. 4 N., R. 37 E., W.M.

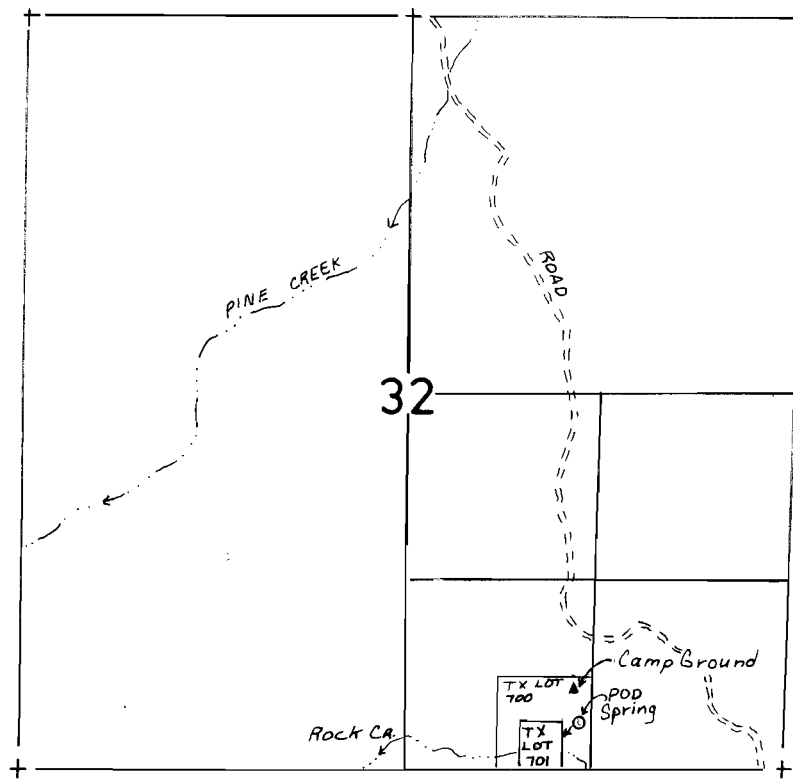

POD- 200' N AND 120' W. FROM THE SE COR. SW 1/4 SE 1/4
OF SEC. 32

FINAL PROOF SURVEY

UNDER

Application No. 59490 Permit No. 44748

IN NAME OF

GLYNN MURPHY

Surveyed 7-15, 1993, by J. MILLER