


N

TSN-R30E

1" = 660 FT  
OR  
8" = 1 MILE

Application No. 63287  
Permit No. 49341

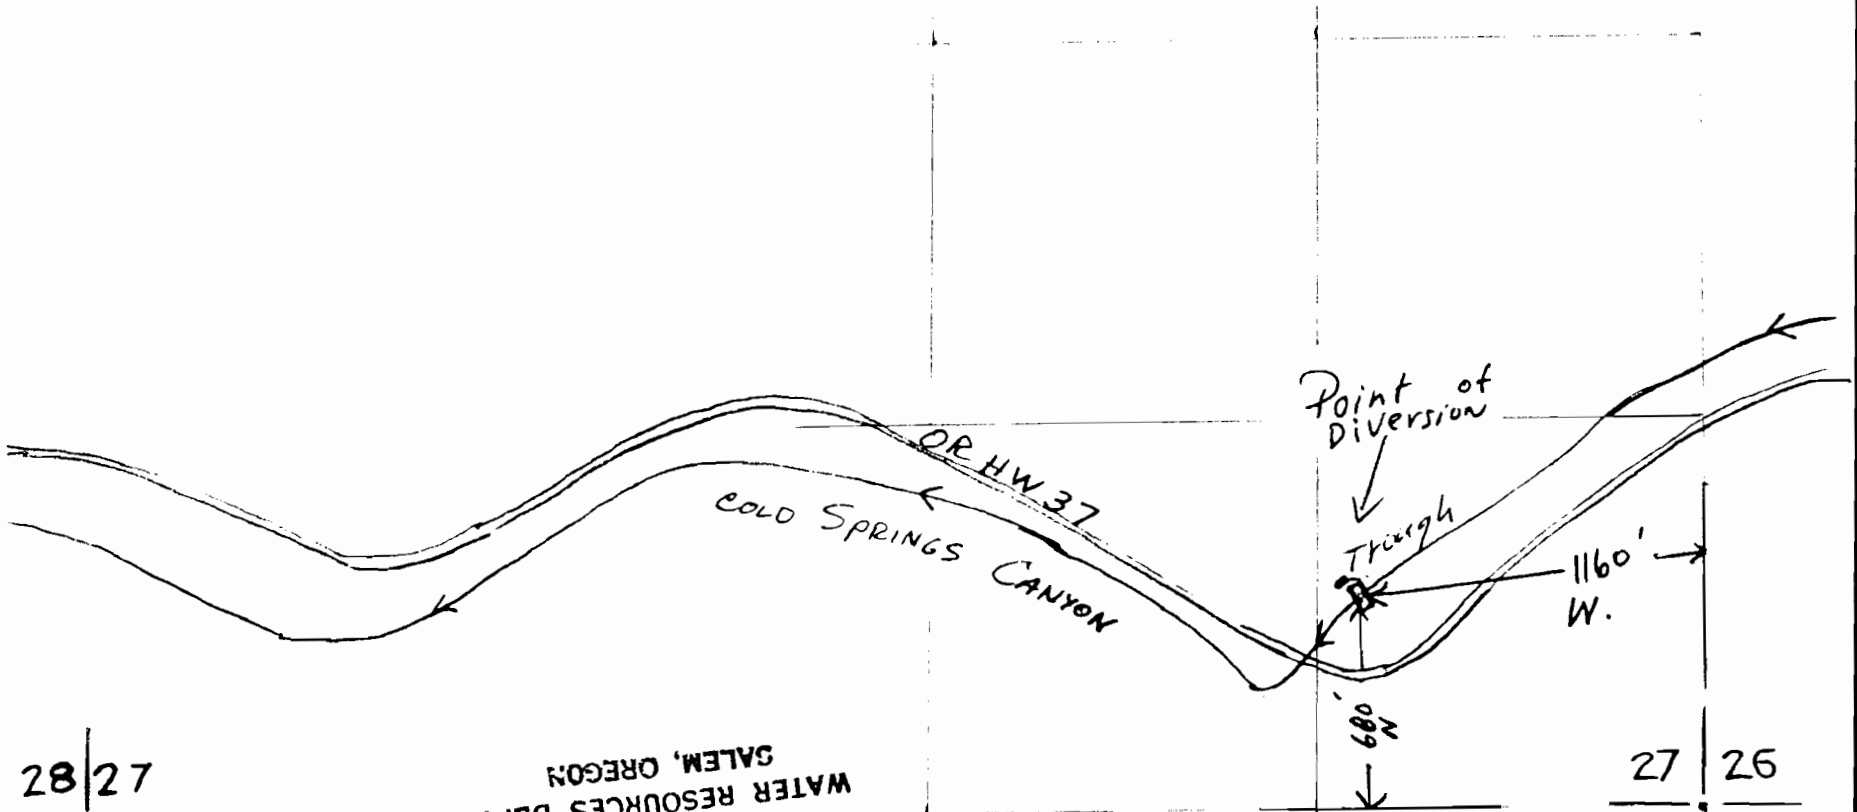

28 | 27

33 | 34

RECEIVED  
APR 2 1985  
WATER RESOURCES DEPT  
SALEM, OREGON

RECEIVED  
FEB 27 1985  
WATER RESOURCES DEPT  
SALEM, OREGON

27 | 26

34 | 35