


Tp. 9. South R. 23 East 10710

Sec. _____
Tp. _____
R. _____

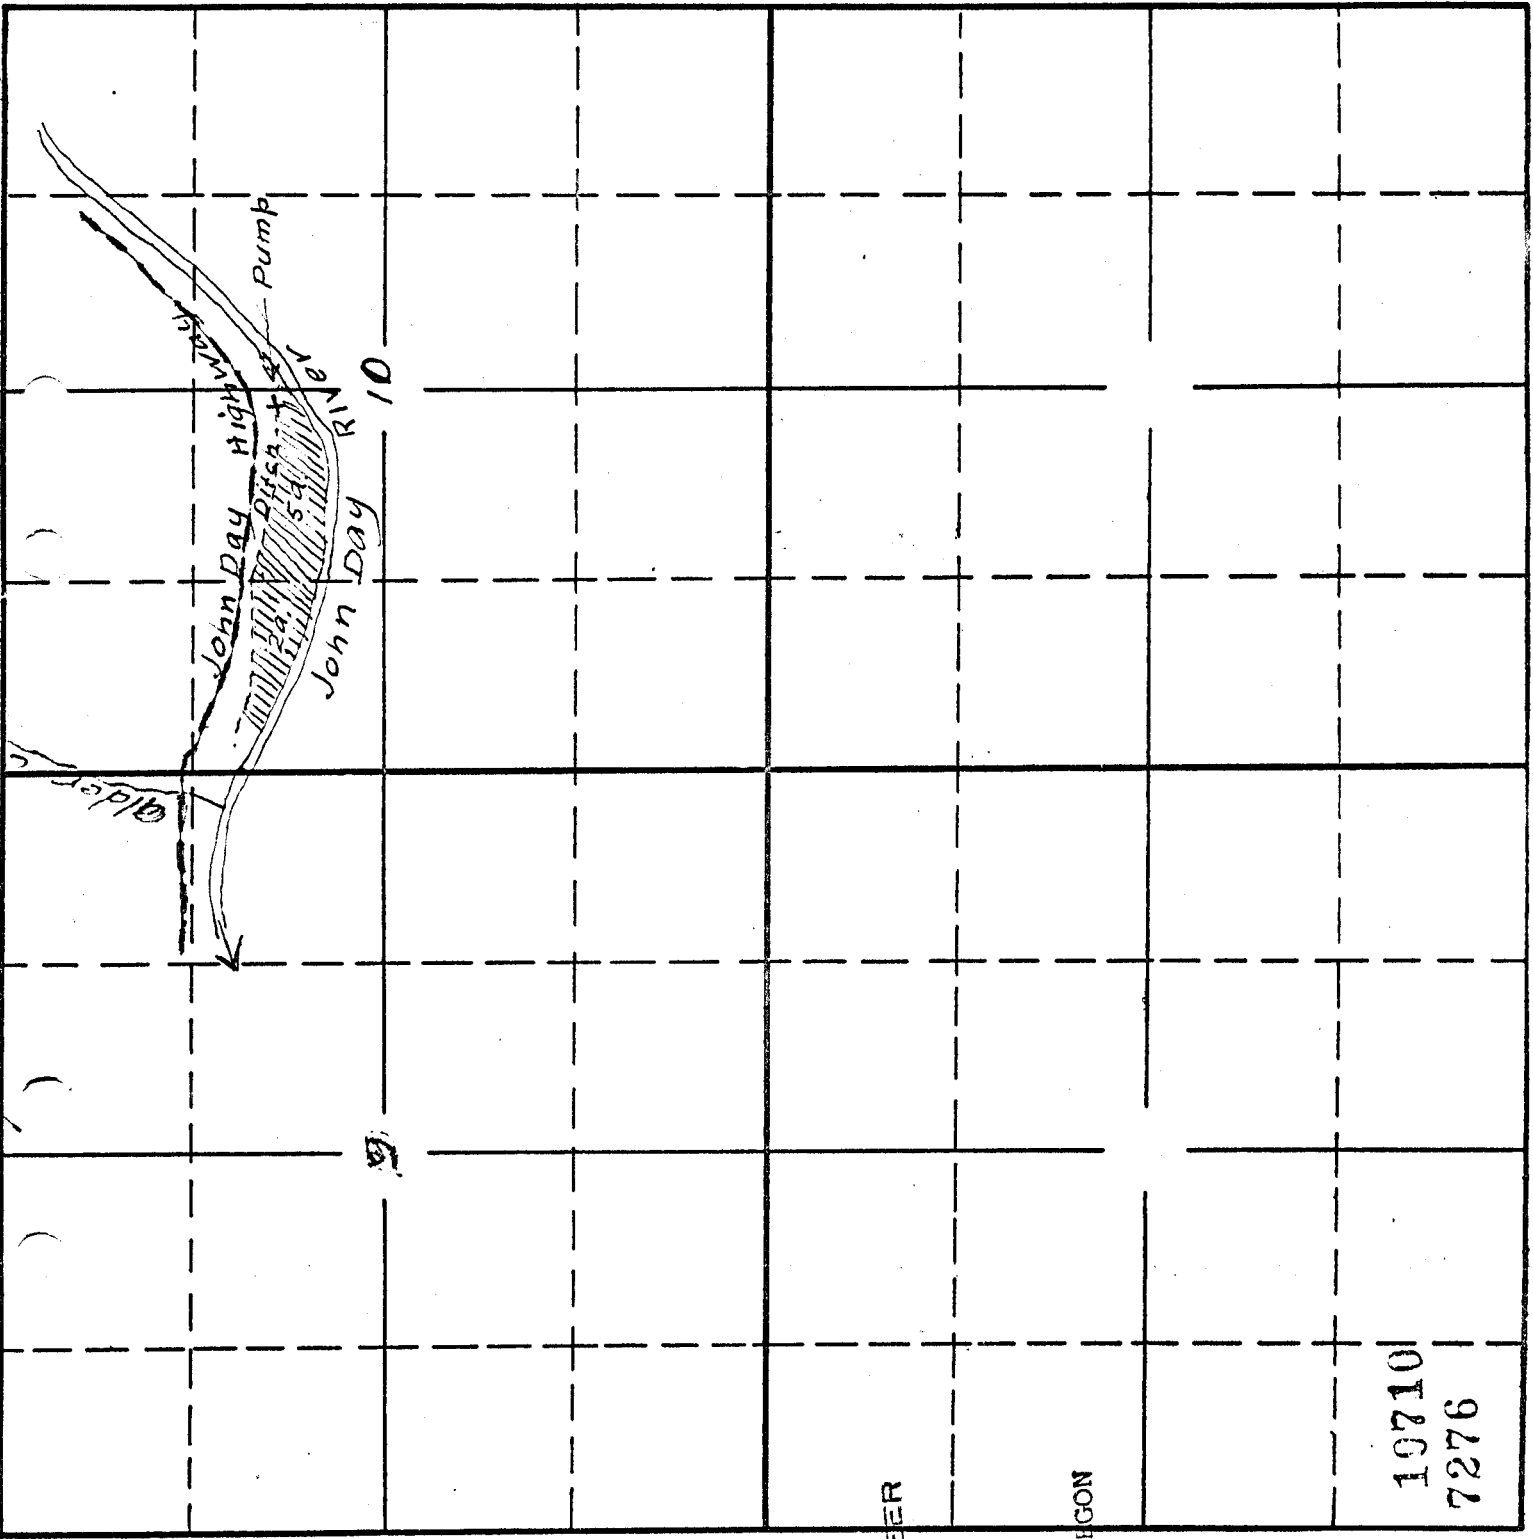

STATE ENGINEER
RECEIVED

APR 14 1926

SALEM, OREGON

Application No. 10710
Permit No. 7276