


# T.3N.R.27E.W.M

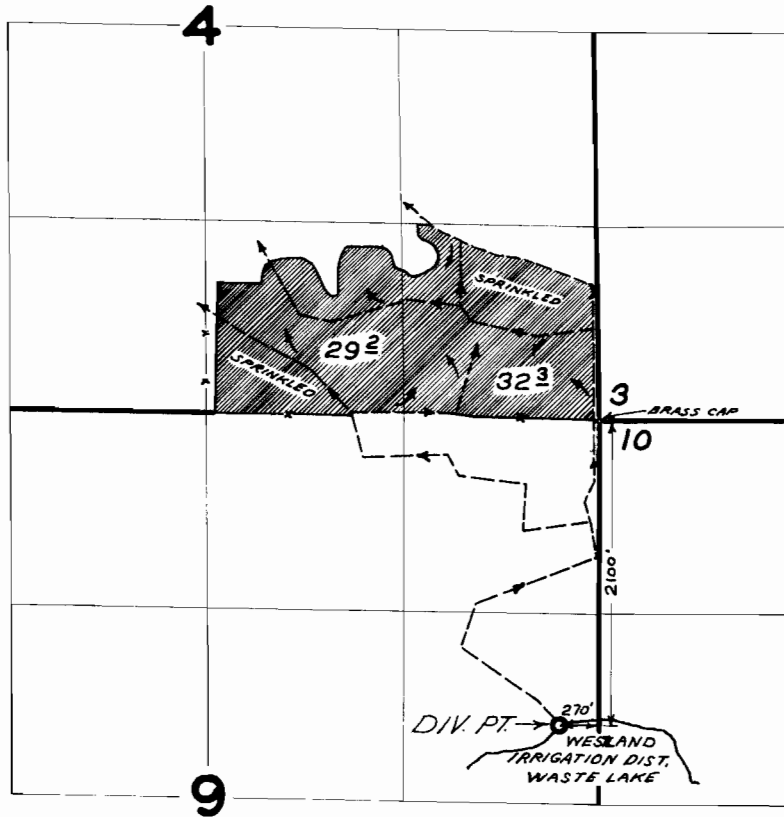

## FINAL PROOF SURVEY UNDER

Application No. 37212 Permit No. 27731  
IN NAME OF

CLARENCE W RUDELL

Surveyed JUN. 22 1966, by L. GOULD